



Location of Houses Grant Ave 22 to 23<sup>d</sup>

Continued on  
Page 1A

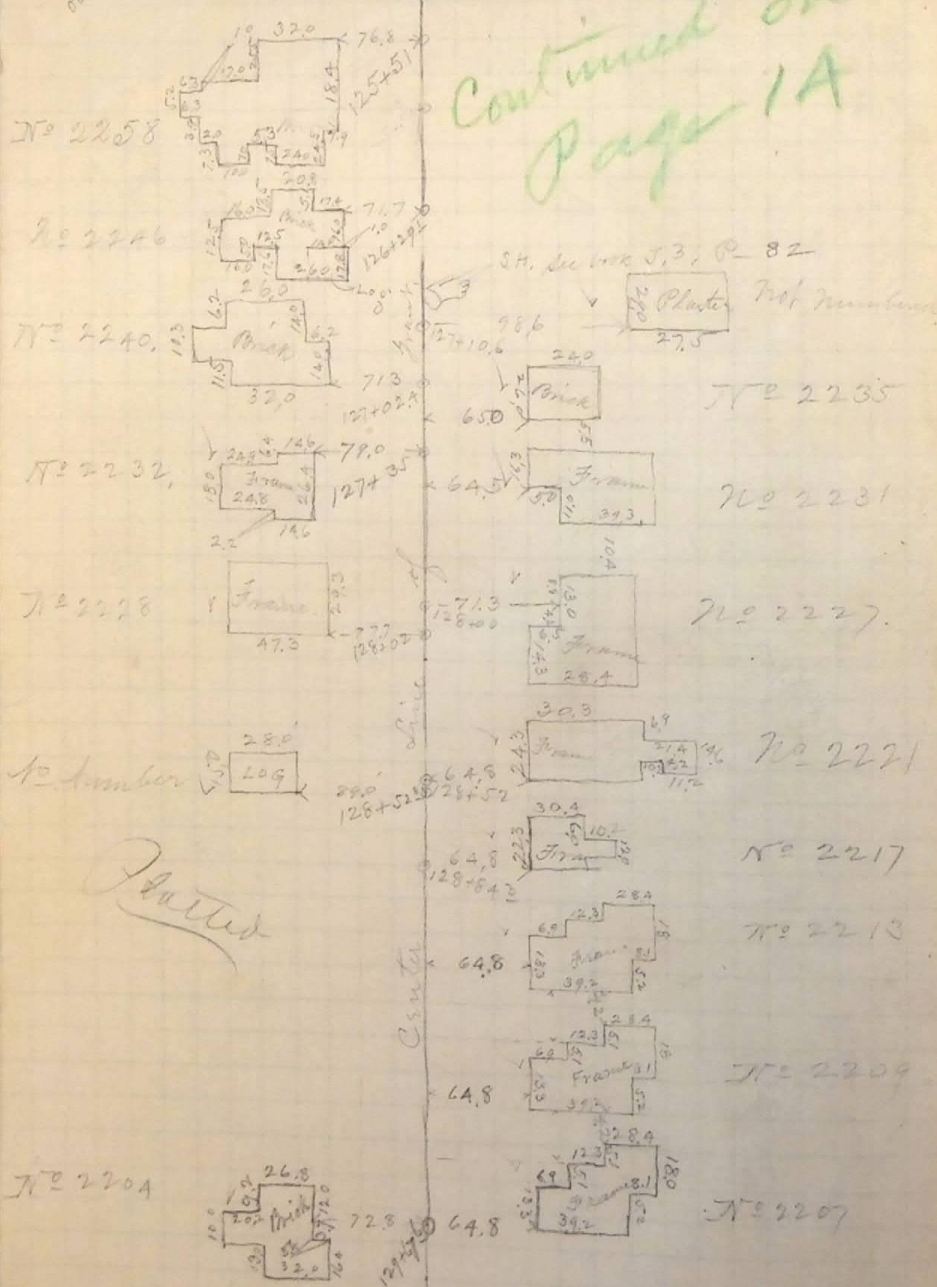

Location and Elevation of Gas and Water Pipes 24<sup>th</sup> to 25<sup>th</sup> Lincoln Avenue.

A. M. Jan 9<sup>th</sup> 91.

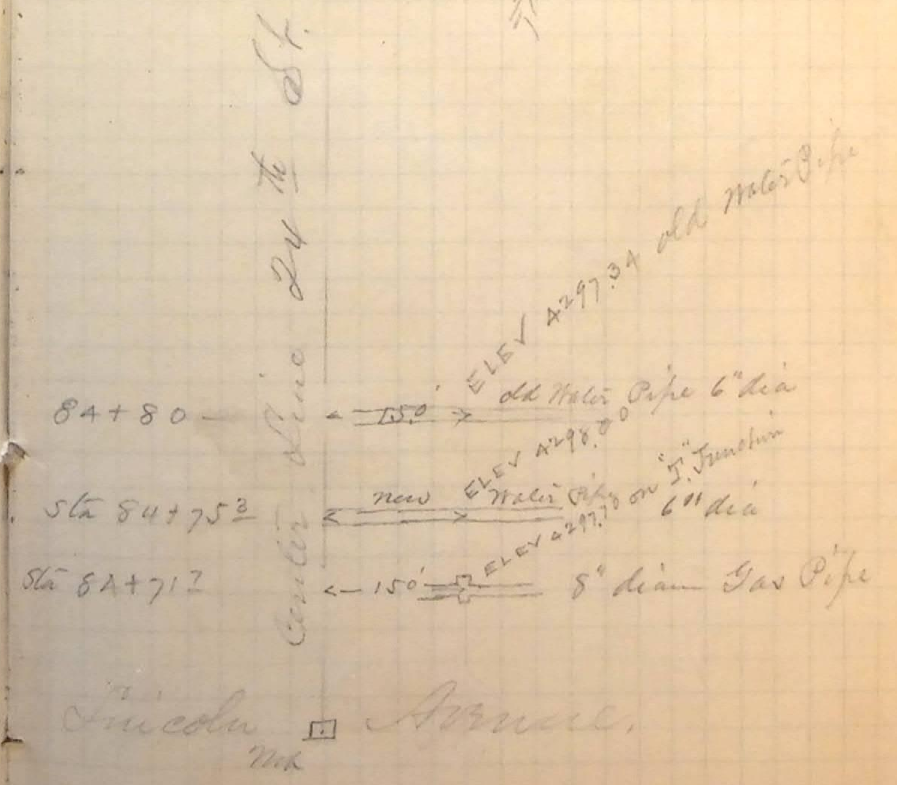

Lincoln Ave.