

Location and Elevations of 4" Gas Pipe on
23rd St bet Lincoln & Grant Aves.

P.M. Jan - 9th 1891

Sta 89+15 α 18.6' → ELEV 4296.28


23rd St

23rd St

of


Sta 86+90 α 18.5' → ELEV 4295.64

Center

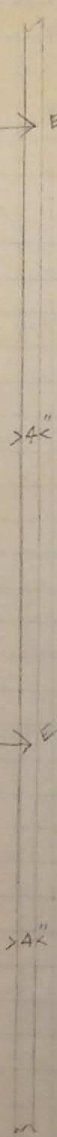

Location of Buildings on Grant Ave. 5
24th St to 23rd St. N. W. Jan 17-91

See next page for Continuation

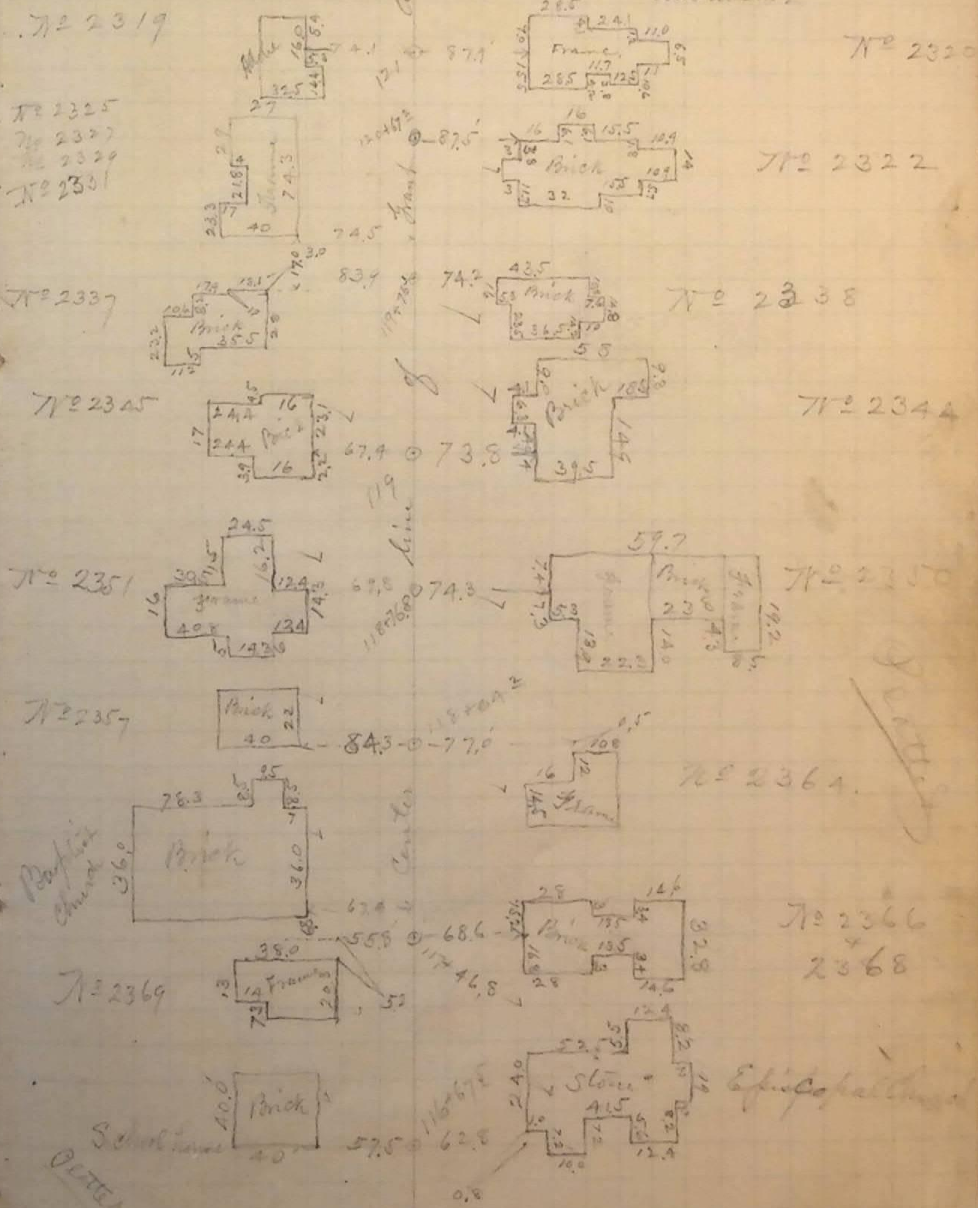

24th St

23rd St