


Plans

Measurements of houses on Grant Ave  
24<sup>th</sup> to 23<sup>rd</sup> Sts continued from last page

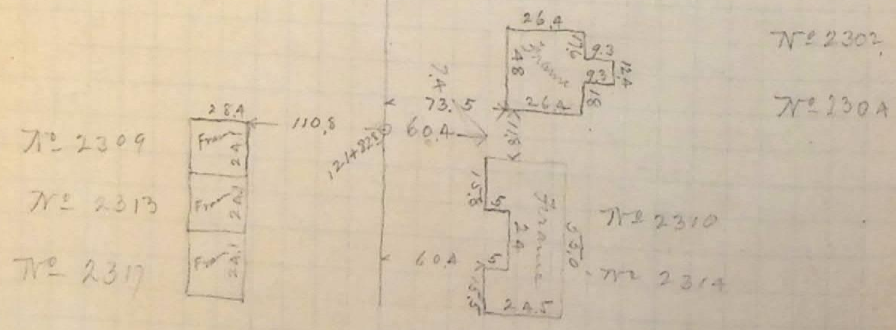

Measurements to the Dimensions  
of Buildings on Grant Ave (21<sup>st</sup> St.)  
West of S.R.G. R.R. tracks

