


Location of
Sewer
A.M. Jan'y 19-91

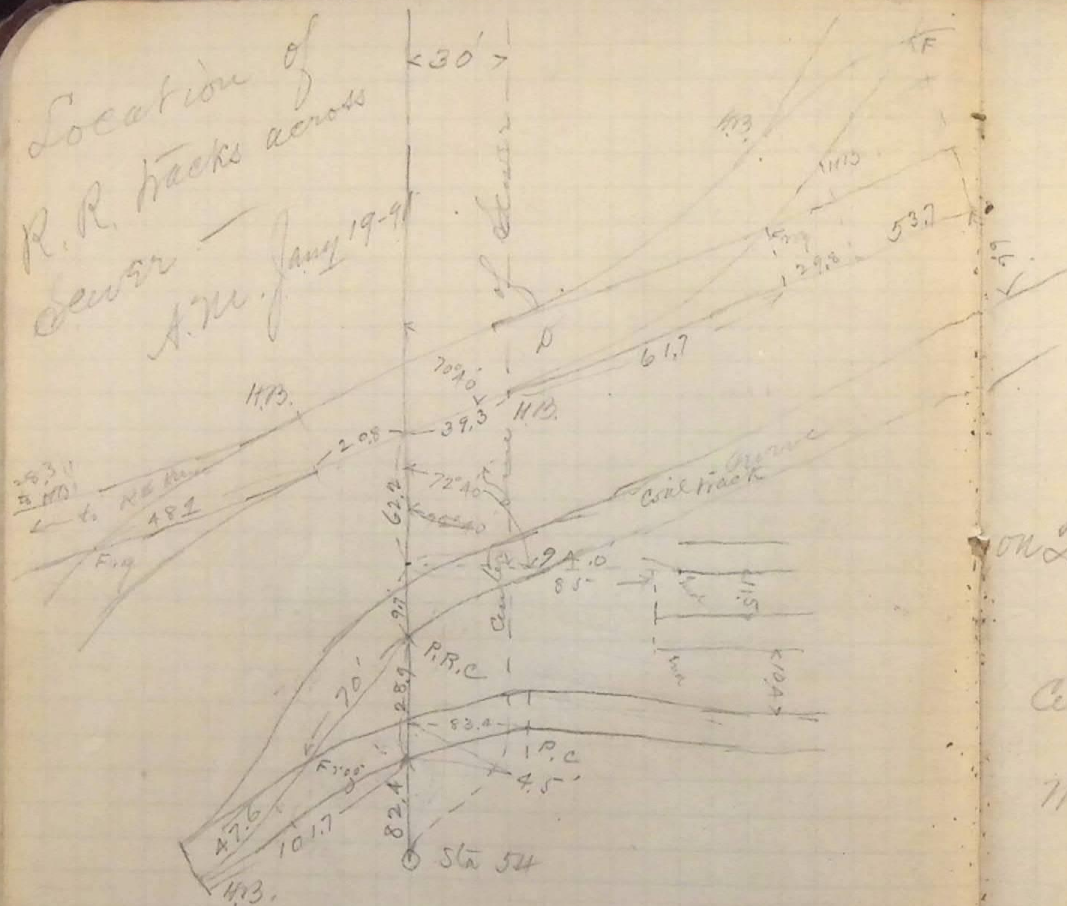

390° and 396°.

Tracks as follows 136° and 142°; 262° and 268°;
Measure north at Rt angles to South Tangent of
From center line of sewer at Main Side Sta 54

follows 337° and 343°; 406° and 412°; 478° and 484°
north at Right Angles to South Tangent line of tracks as
From center line of sewer at Station 51+60 Measure

Location of 4" Gas Main running E. & W.
on 23^d St at Grant Ave.
Said Main being 18 ft South of
Center of 23^d St at Sta 92+02^d
with Elevation of 4297.66

A.M. Jan'y 21-91