


water, the water would find its way in almost any quantity into old drain, & carry with it soil, mud, gravel, & sand.

The known condition of old drain was very bad anyway, being considerably obstructed & silted up.

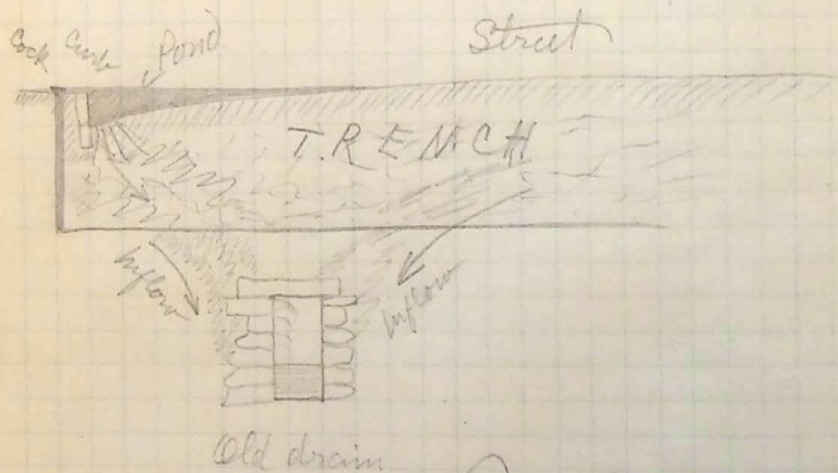

D. W. Perkins,
City Engineer.

Location and Elevation of top of a Modern
Box Culvert 10' x 10' Running N.E. & S.W.
15.0 feet West of Center of Washington Ave
opposite Sta 123+74. bet 22nd & 23rd St
Elev = 429.48.

July 16th 1891