


Location and Elev of 6" Water
running E and West on
Washington Ave bet 23rd & 24th

15 feet West of Center line Washington Ave
Sta 119+05.3 Elev = 4300.84

July 20th 1891

Location and Elev of Gas and New
Water Mains 24th Street Washington Ave

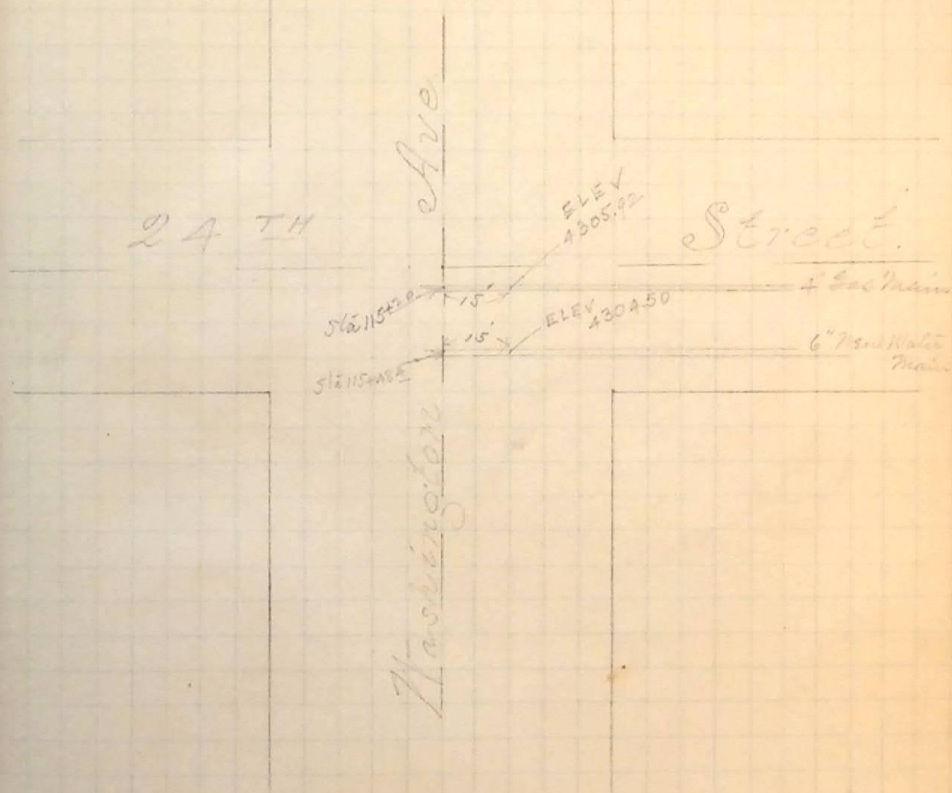

July 21st 1891