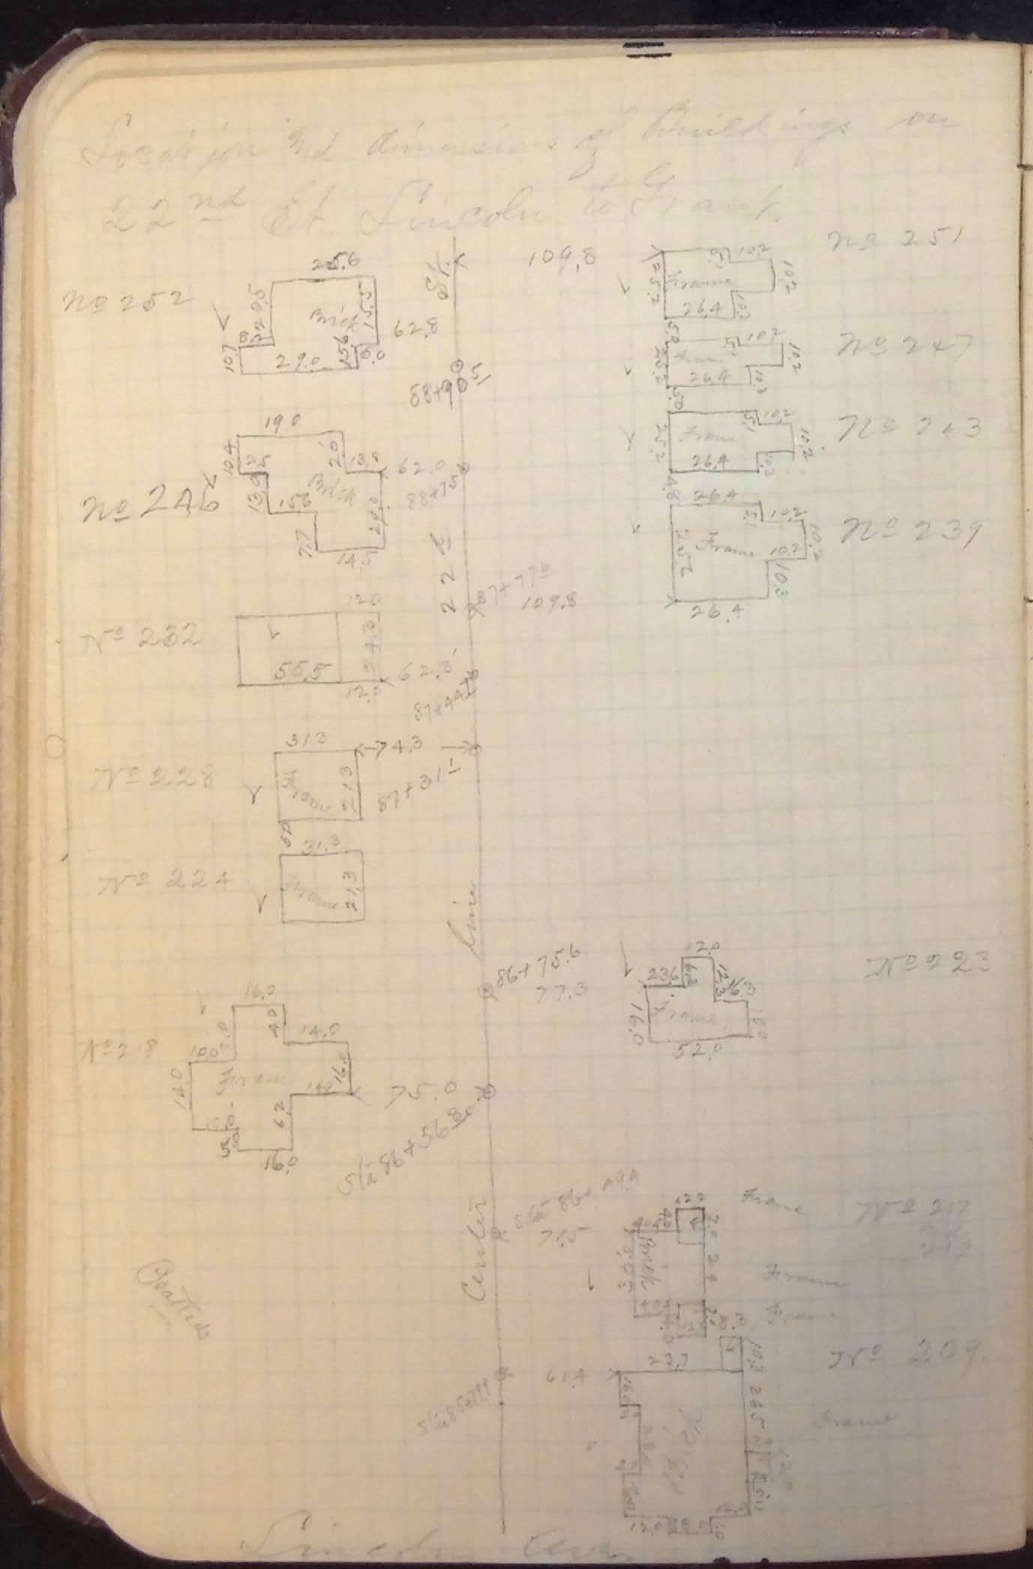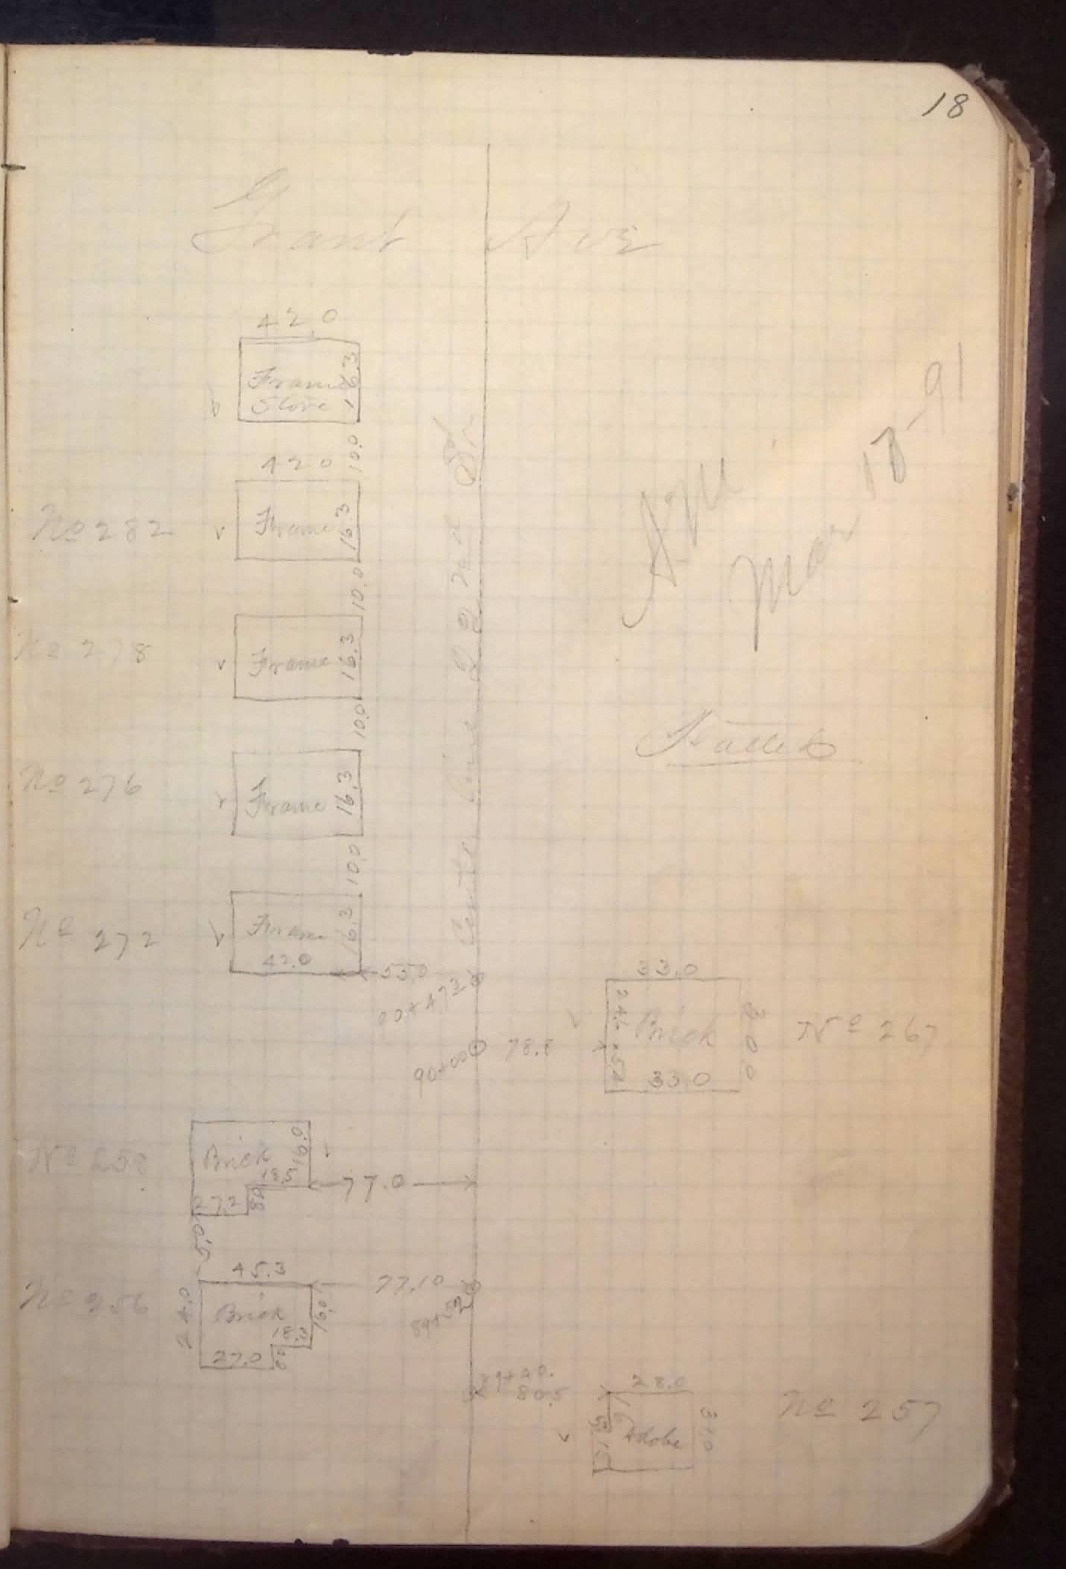Location and dimensions of buildings on
22nd St. Lincoln to Grant.