


Location and Elev of Pipes at the
Intersection of Washington Ave + 25th St.

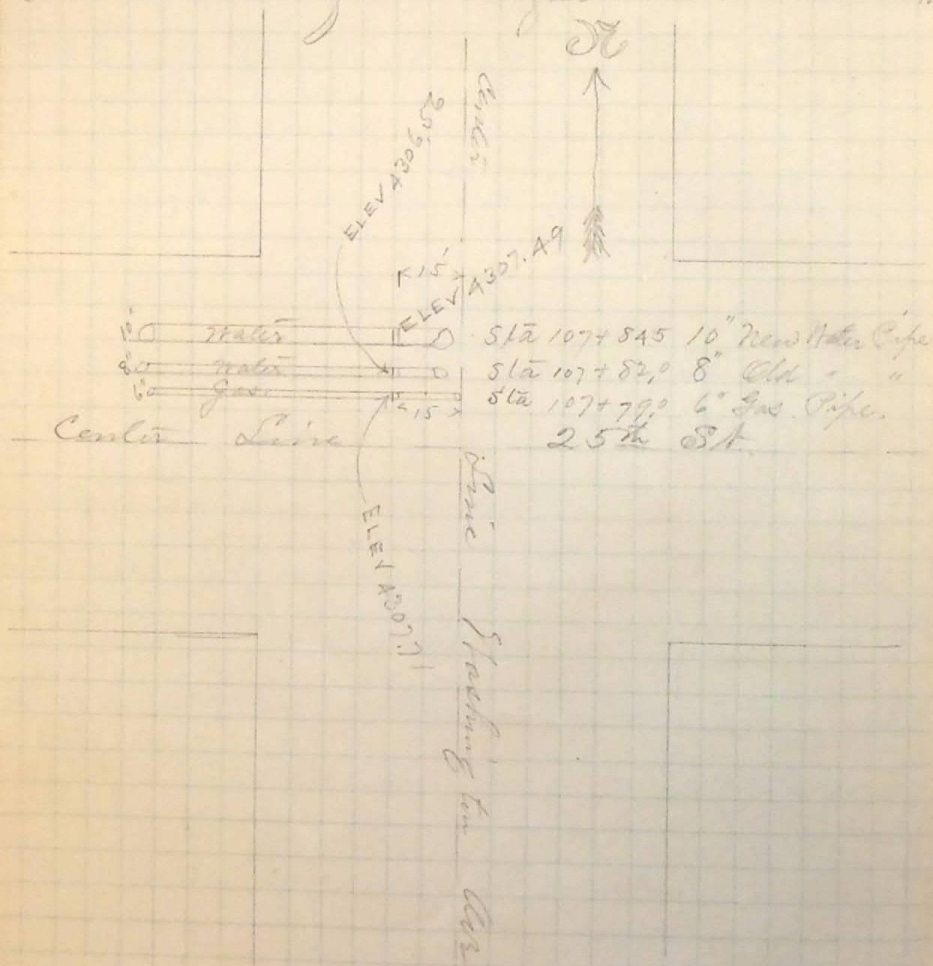

A.M. Mar 20th 91

Location and Elev of a 10" or 12" Sewer
Pipe running E-W across Washington
Ave. at Sta 106+509 (Between 25th + 26th St.)

Elev = 4303.02 taken on top of Pipe
15 ft West of Center of Washington Ave.

A.M. Mar 20-91

Location and Elev of old 6" Water Pipe
running E-W across Washington Ave
at Sta 103+790. (Between 25th + 26th St.)

Elev = 4307.39 taken on top of Pipe
15 ft West of Center of Washington Ave.

A.M. Mar 21-91