


Location and Elev. of Pipes at Intersection
of Washington Ave and 26th St.

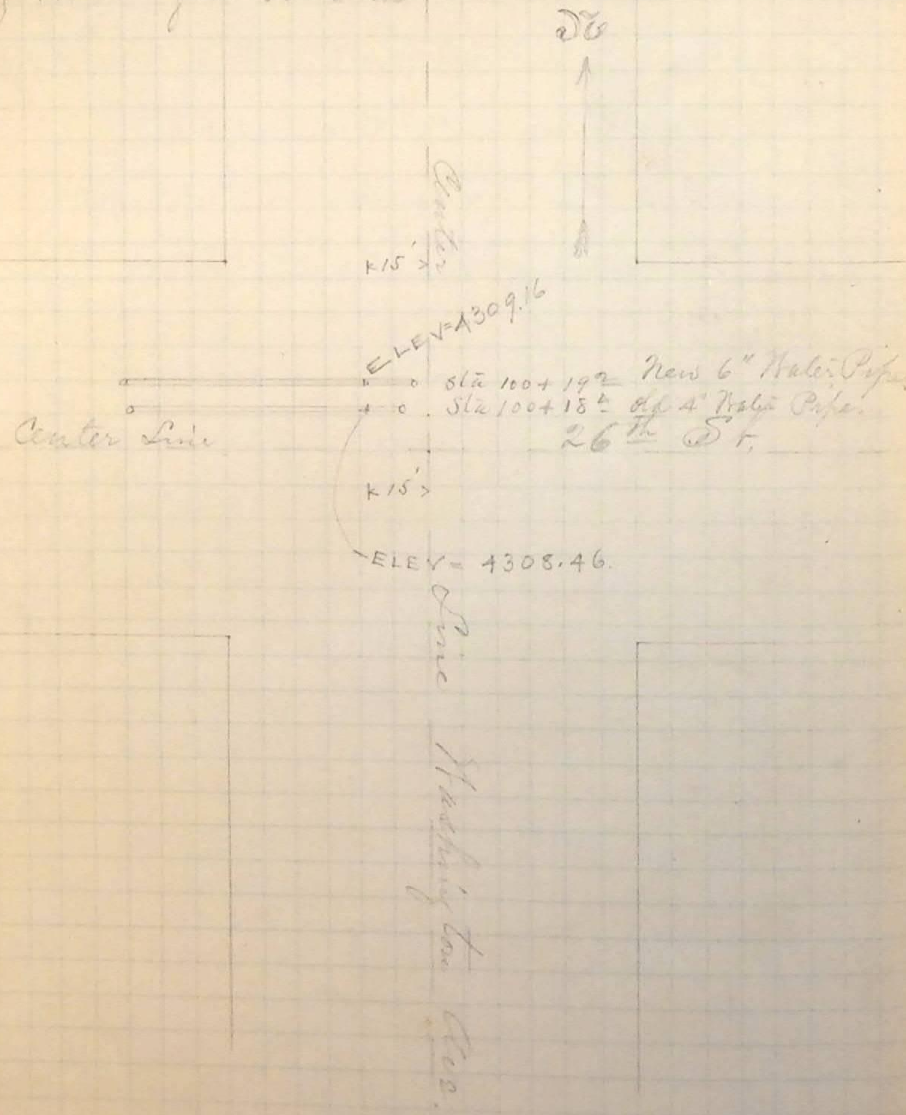

A.M. Mar 21-91

Location and Elev. of a Wooden Box
Main about 8' x 10' running E + W across
Washington Ave at Sta 101+08.

(Box 25th + 26th Sts.)
Elev = 4305.87 taken on top of drain
15ft West of Center of Washington Ave.
P.M. Mar 21-91