


Measurement of Rip-Rap
at outlet of Cityfall Sewer Water Pipe.
P.M. Apr 3^d 91

North side of Sewer

$$11.0 \times 7.5 + 1\frac{1}{3}' = 110 \text{ cu ft.}$$

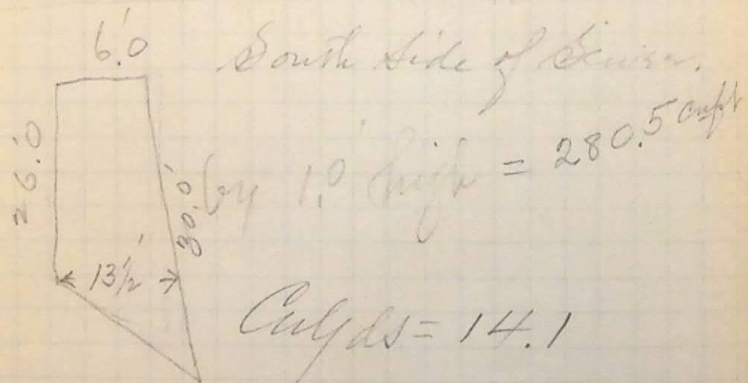


H. C. P.

Note of
C. P. Sealing

New P.M.
April 3-91

