Location of Building Fronts on Washington Ave. from 24th to 23rd

S. Pl. Mar 6-91

W. Side

E. Side

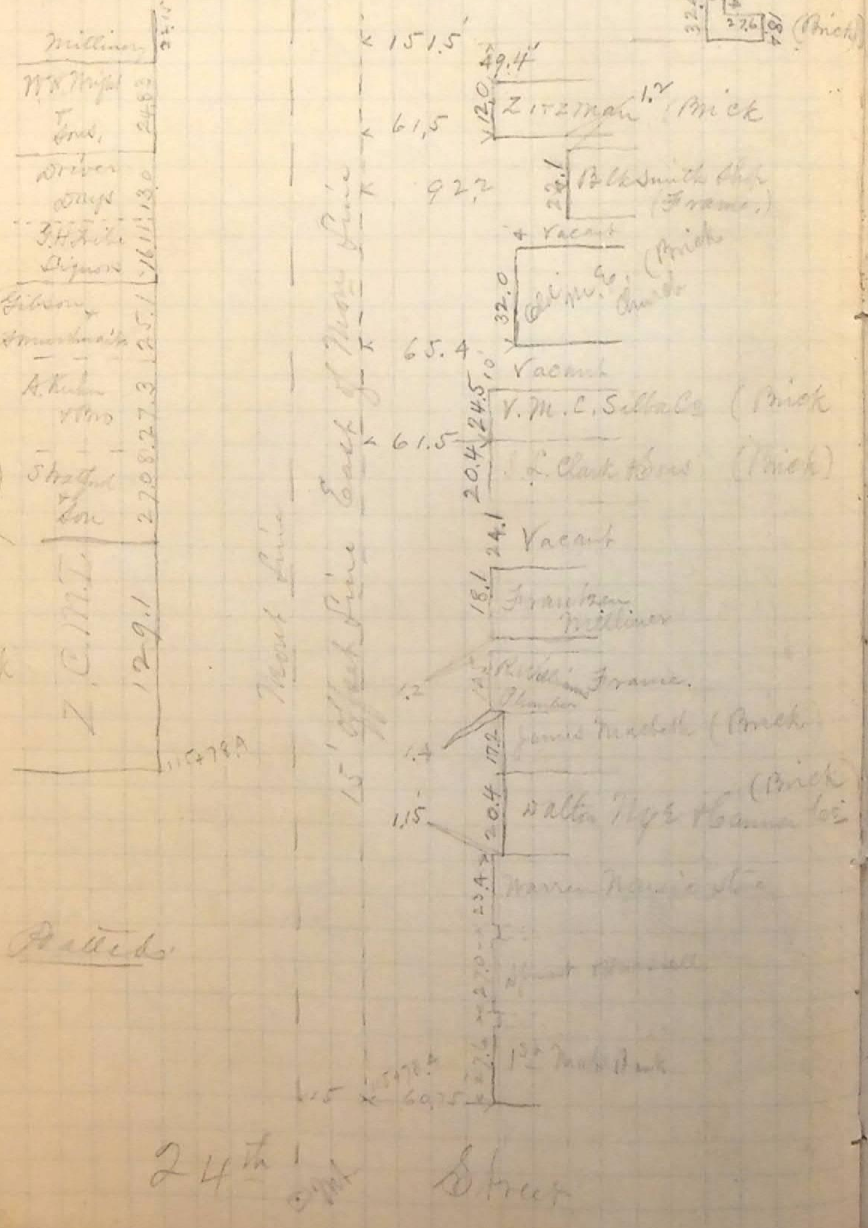
Millinery
W.B. Wright Tinsmith
Brick
Brick
Brick