

Location of Building Fronts on 25th St
 St Frank to Washington

A. M. Mar 27th 1891
 North Side
 South Side



N. Side

Frame	W. H. Stearns	14.35
Brick	Winn	28.70
Frame	J. E. H. H. H.	24.45
Brick	Little King	24.45
Brick	John	21.05
Brick	Jones & Lewis	21.45
Brick	LUKE'S	21.45
Brick	Phillips	21.05
Brick	Adams	20.36
Brick	Grand	22.0
Brick	Adams	18.75
Brick	Thomas	22.0
Brick	Pickles	21.78
Brick	W. H. Stearns	22.45

25th St

Center Line

211.90
 294 + 92.56

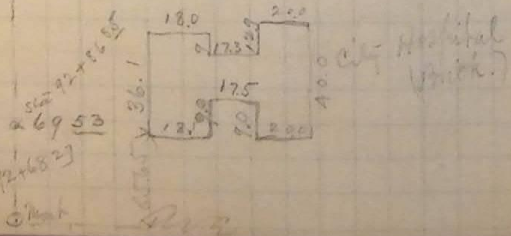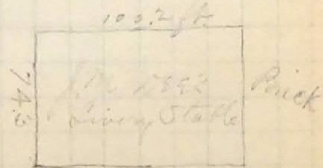

North Side

South Side

Washington Ave

Brick	Prison	148.1
Brick	Hotel	103
Frame	Alley	103
Frame	Brick	30.2
Frame	Barber	30.2
Frame	Cigars	29
Brick	Brick	10.1
Brick	L. Six	20.7
Brick	Sanborn	20.0
Frame	Cigar	16.57
Frame	Brick	12.37
Frame	Brick	3.55

25th St

Center Line

665.85
 663.30