



Location of Building Frankon 25<sup>th</sup> St  
Hall to Lincoln A. N. Apr 22/91

North Side

South Side 31


North Side

South Side

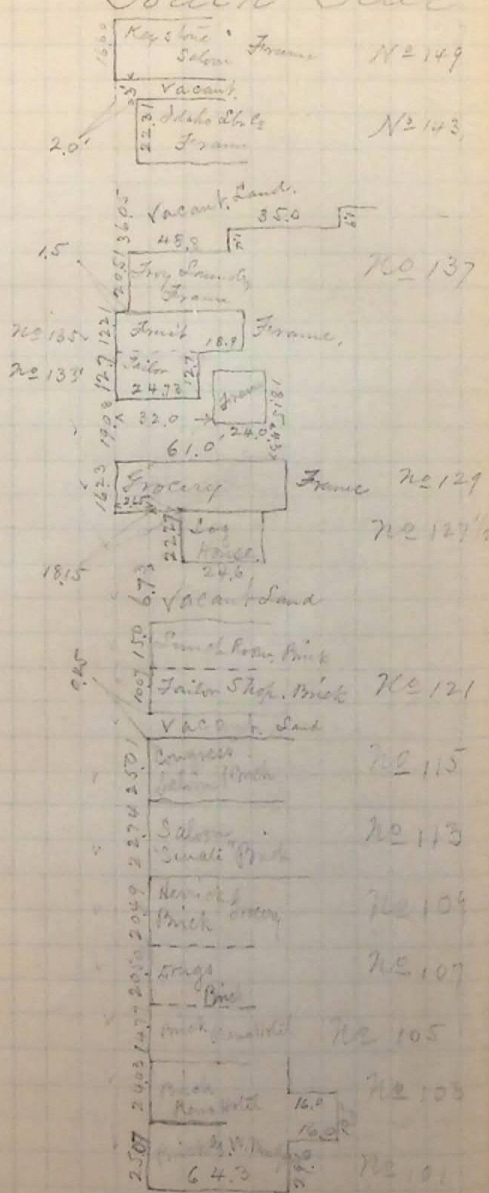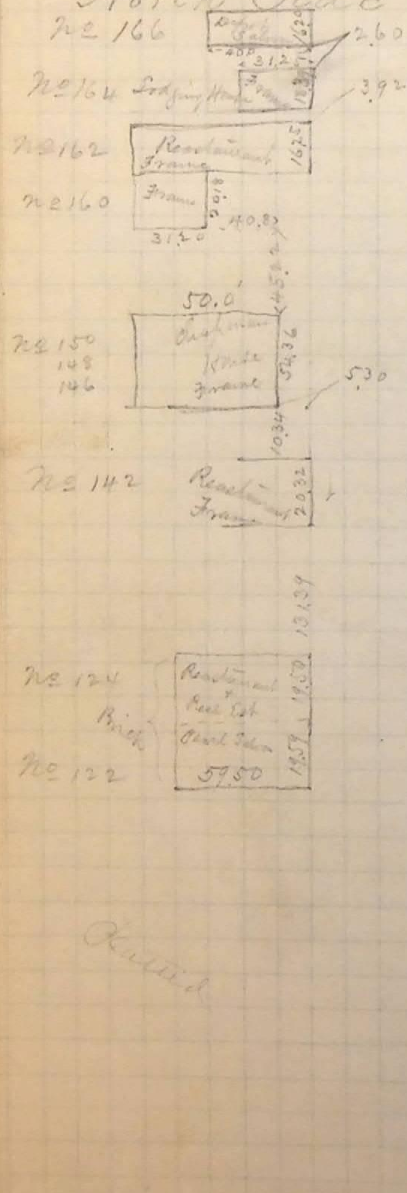

Lincoln Ave.

Ave.

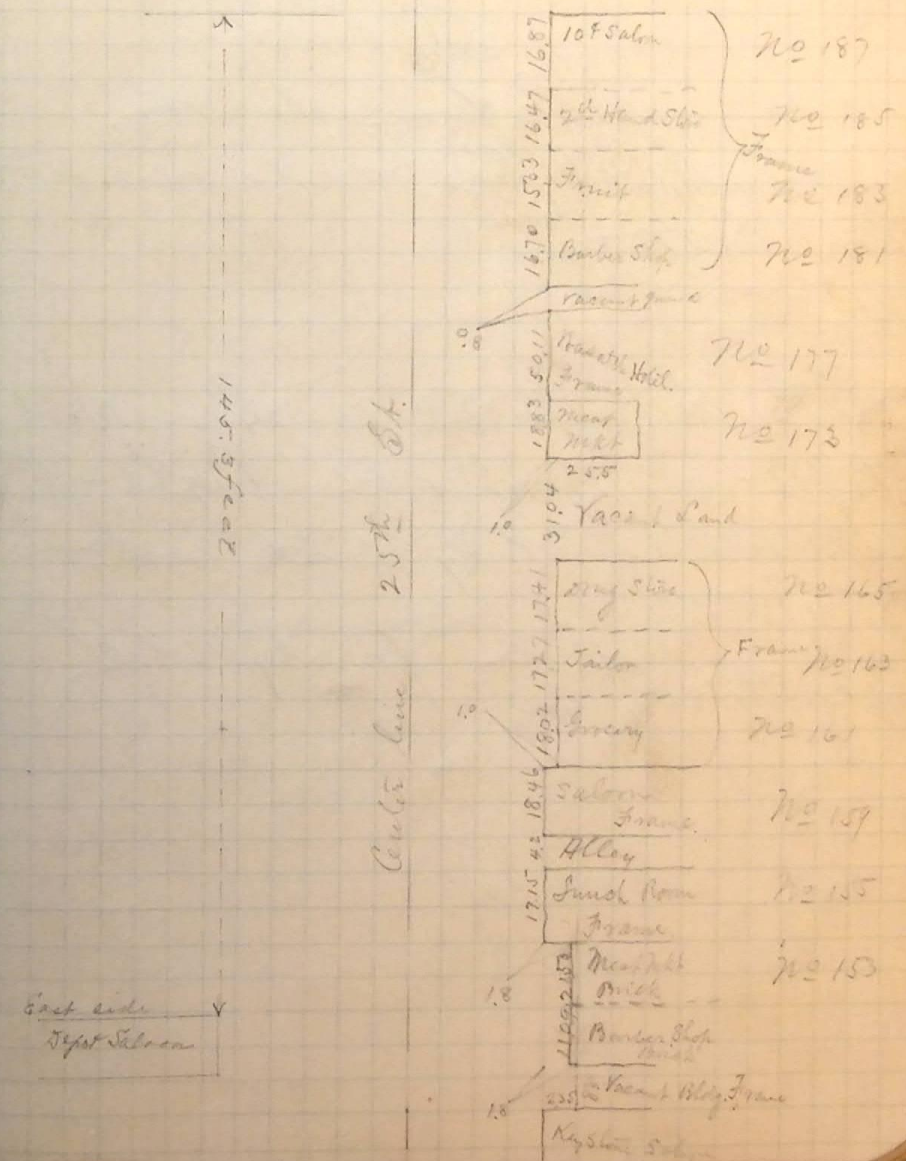

WALL Ave