


Location of Building Fronts on 25th St.
Between Lincoln & Grant.
South Side. P.M. Apr 28-91
North Side


Lincoln Ave.

Line 25th St


Corner 12th St

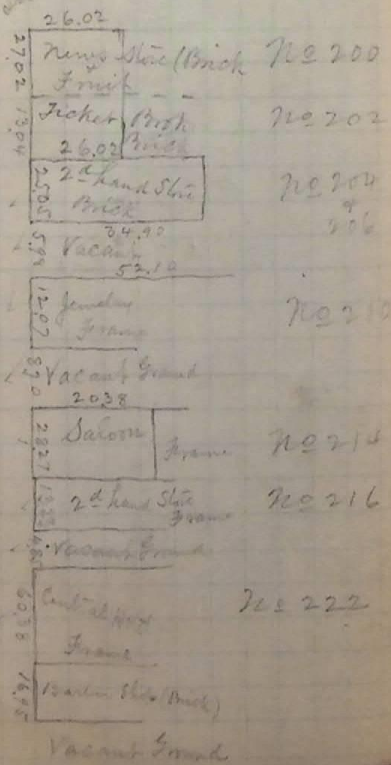


No 201

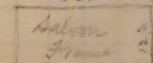

No 203

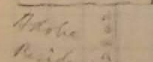



No 207

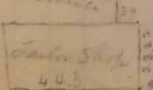


South Side

North Side 43


No 217

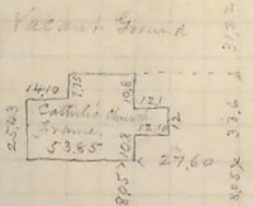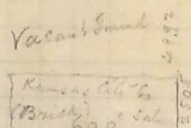


No 233

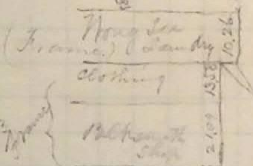


Alley

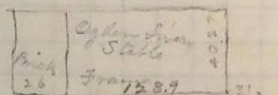


No 251

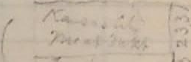


No 253

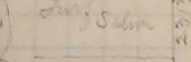


No 255

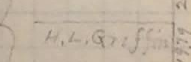


No 257

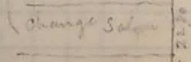


No 265

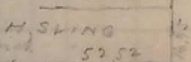

No 271

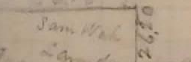

Corner Line 25th St

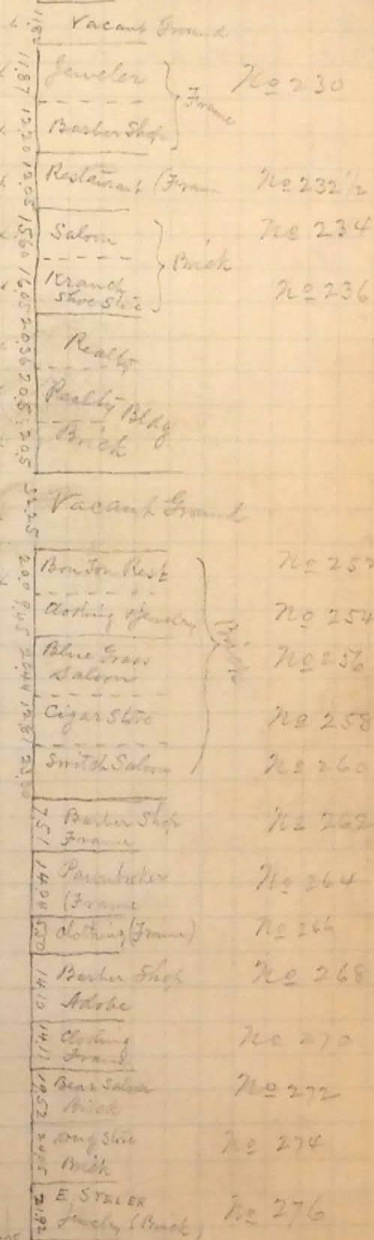

56.91+0275

Grant

Ave