


Location of Buila by route on Washington
Avenue between 25th & 26th Streets

Platted
May 19th 1891
W.M.B.



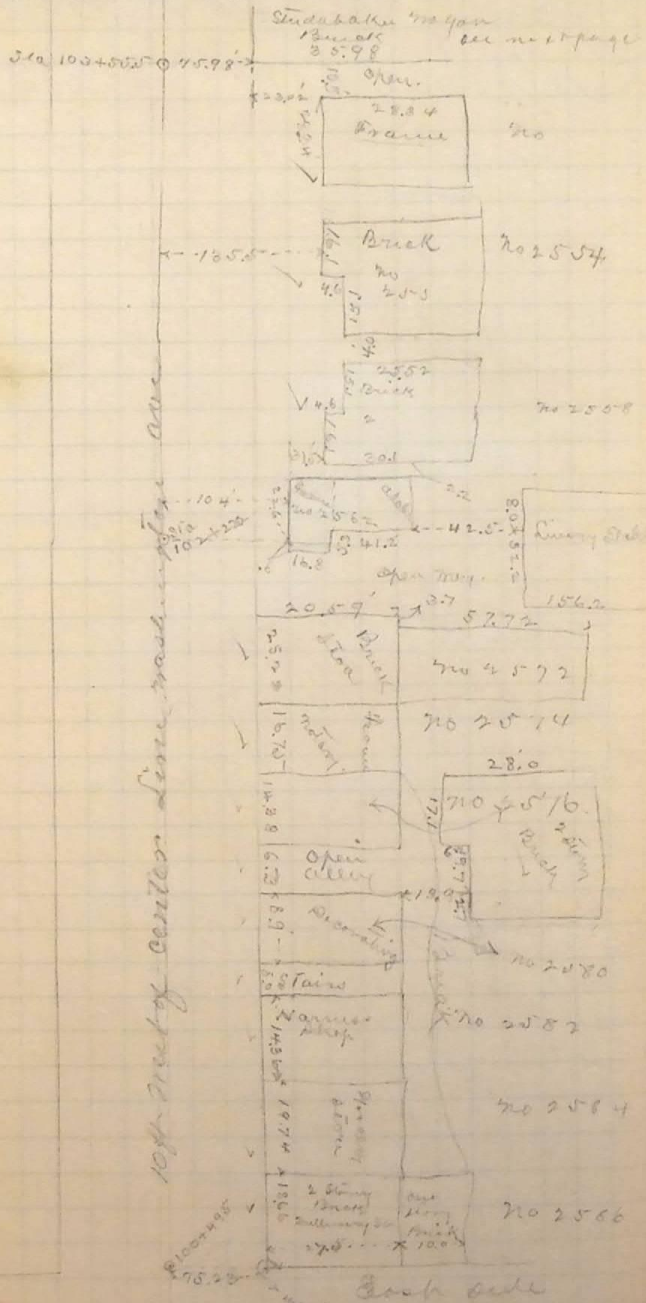


Street
26th Street
100' 100'

all.
May 8th 1891.
W.M.B.

Platted
May 19th 1891
W.M.B.

10' West of center line Washington Ave

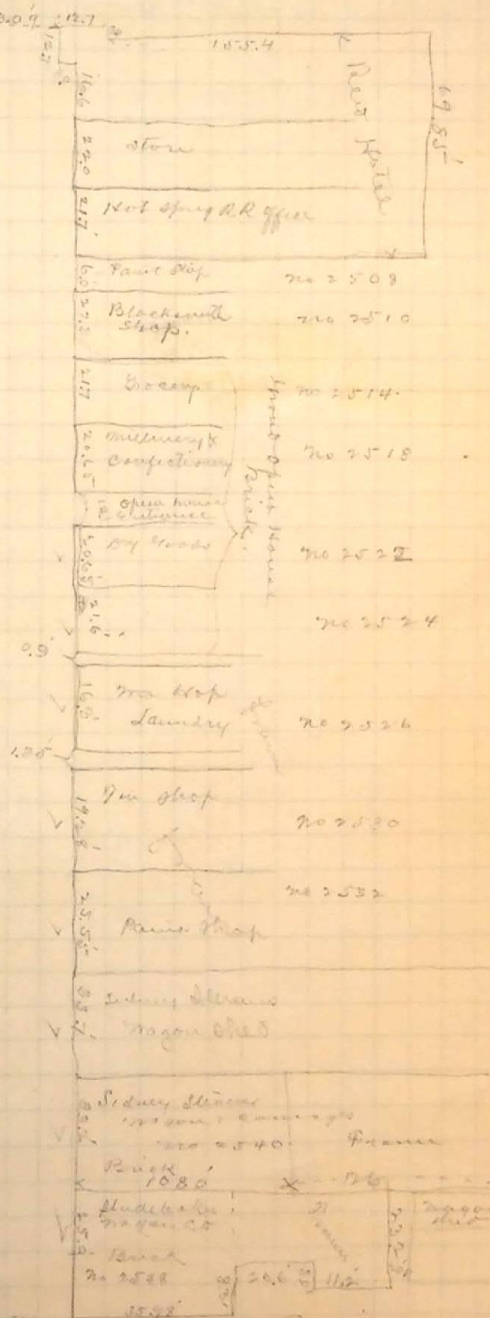

Street
from opposite
East side