


Location of Building fronts on Grant Ave
between 24 + 25 Streets

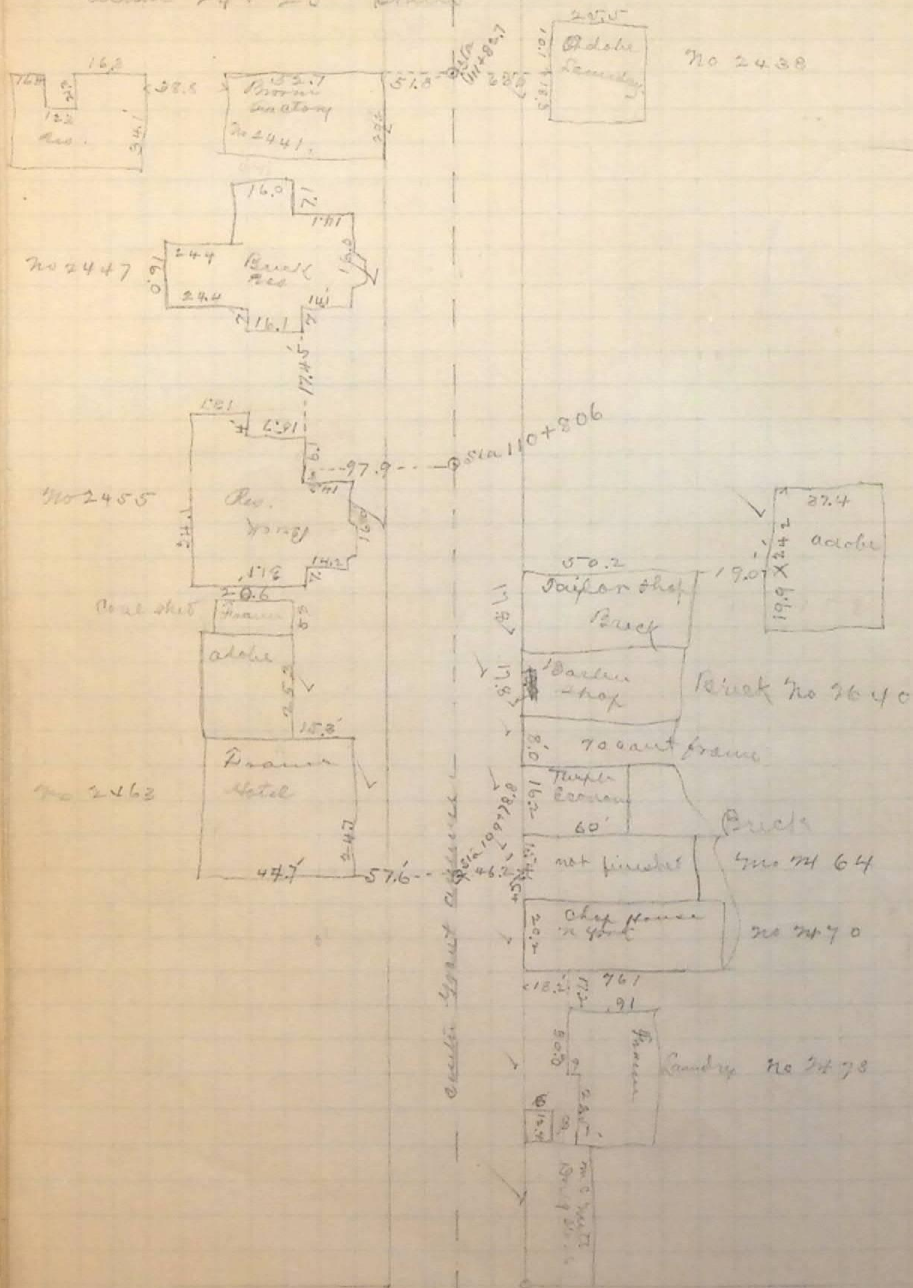

West side

25 Street

Monument 25 + Grant Ave

Plat 6
May 8th 1891
N.W. and E.W.

Monument 25 + Grant
24th St.

May 8th 1891
P.M.
N.W.

