



Location of Building fronts on Lincoln
 Avenue from 24th Street to 25th St.
 May 10th 1917

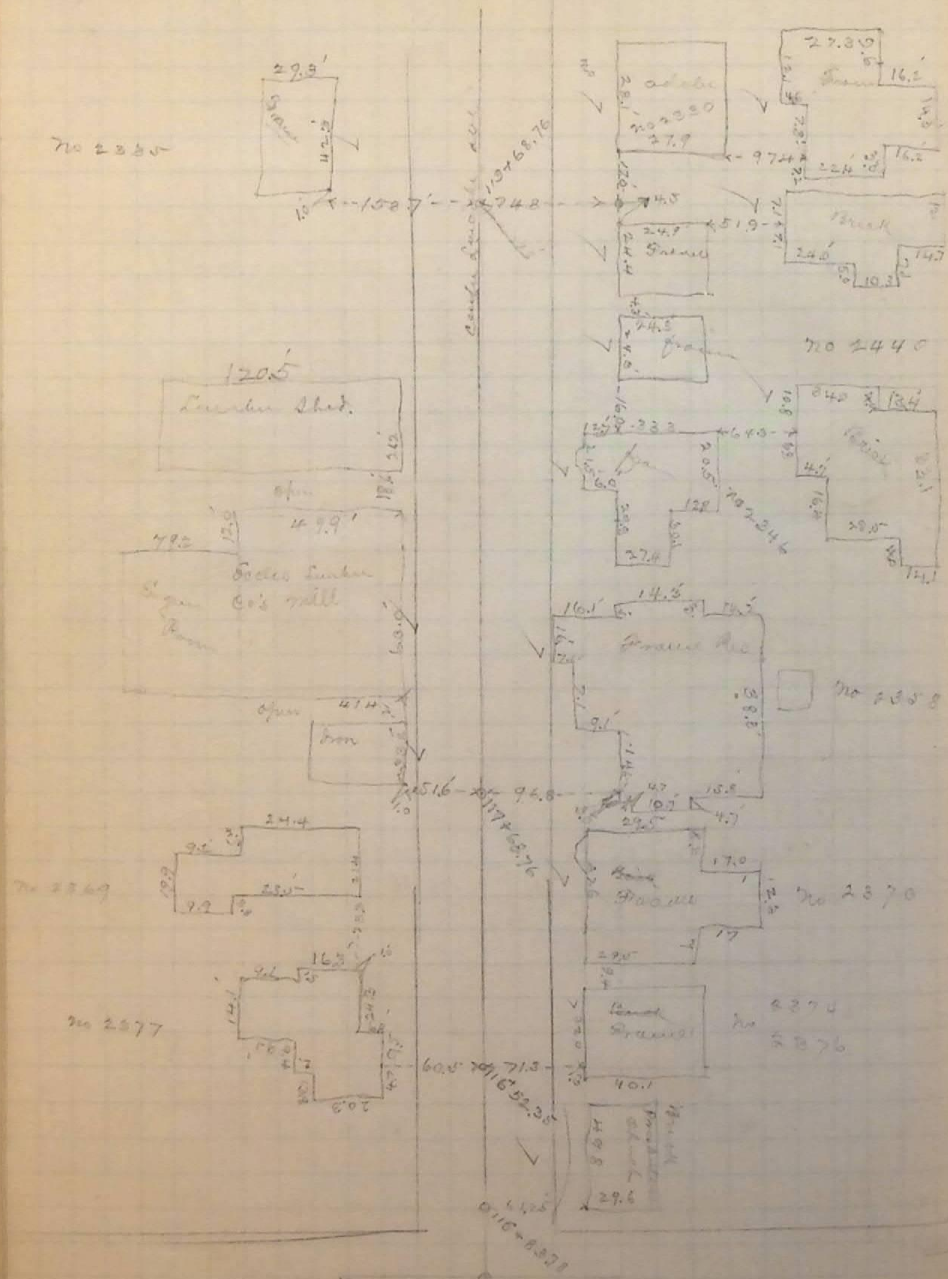

24th Street
 25th Street

Platted
 May 10th 1917
 1711

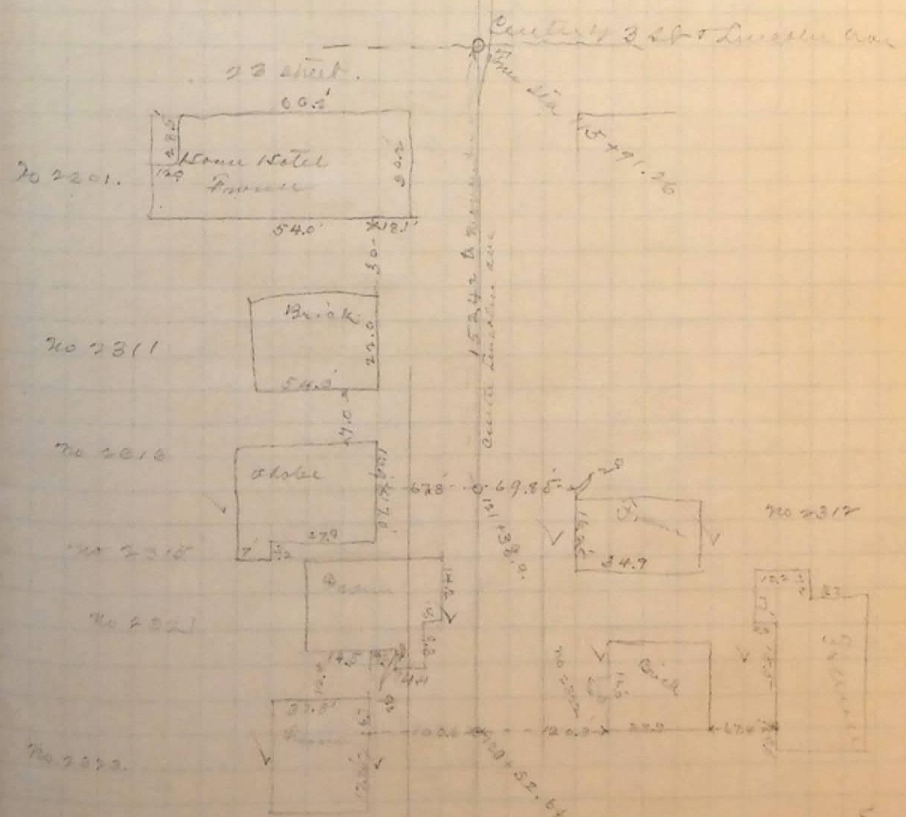

Lincoln Avenue