


Location Building fronts on
Lincoln Avenue from 23rd to 22nd Sts
in section west of

May 11th 1891

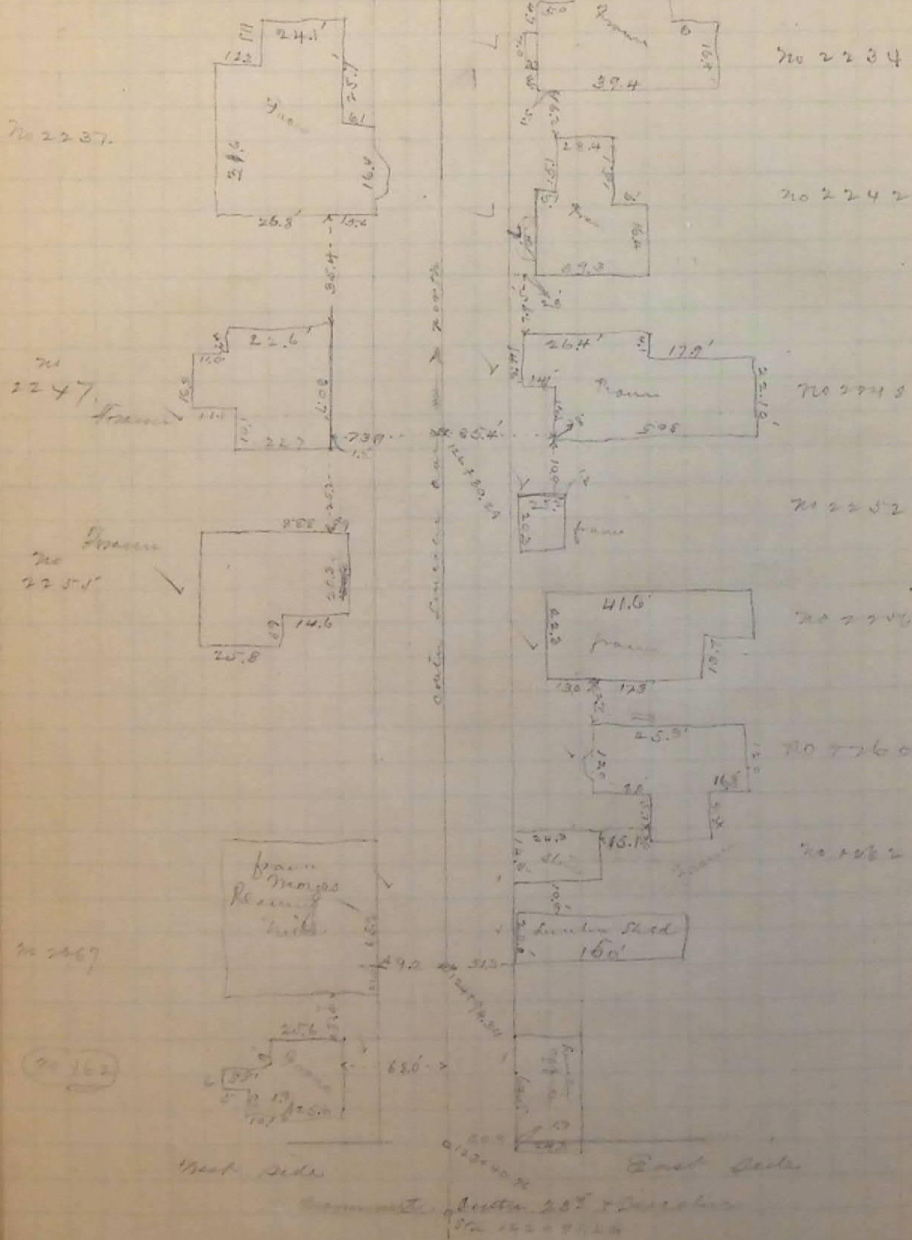

Platted
May 12th 1891

