


Location of Buildings on Lincoln Avenue  
between 24th and 25th streets  
East side West side

May 12<sup>th</sup> 1891  
N.M.R.

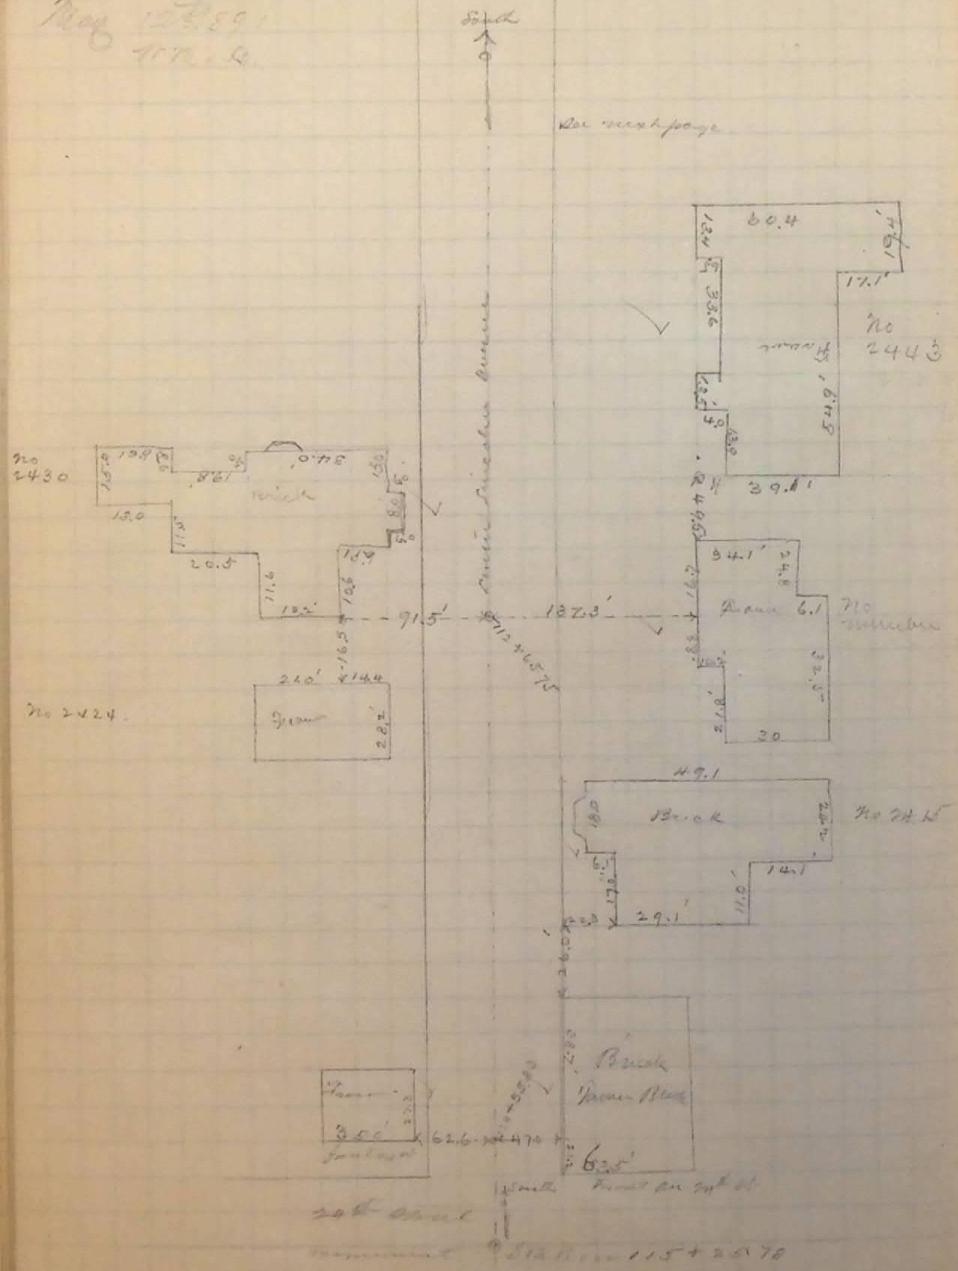

Plotted  
May 19<sup>th</sup> 1891  
N.M.R.  
next page

