


Location of buildings on S4th Street from
Wall to Lincoln Ave May 17th 1891

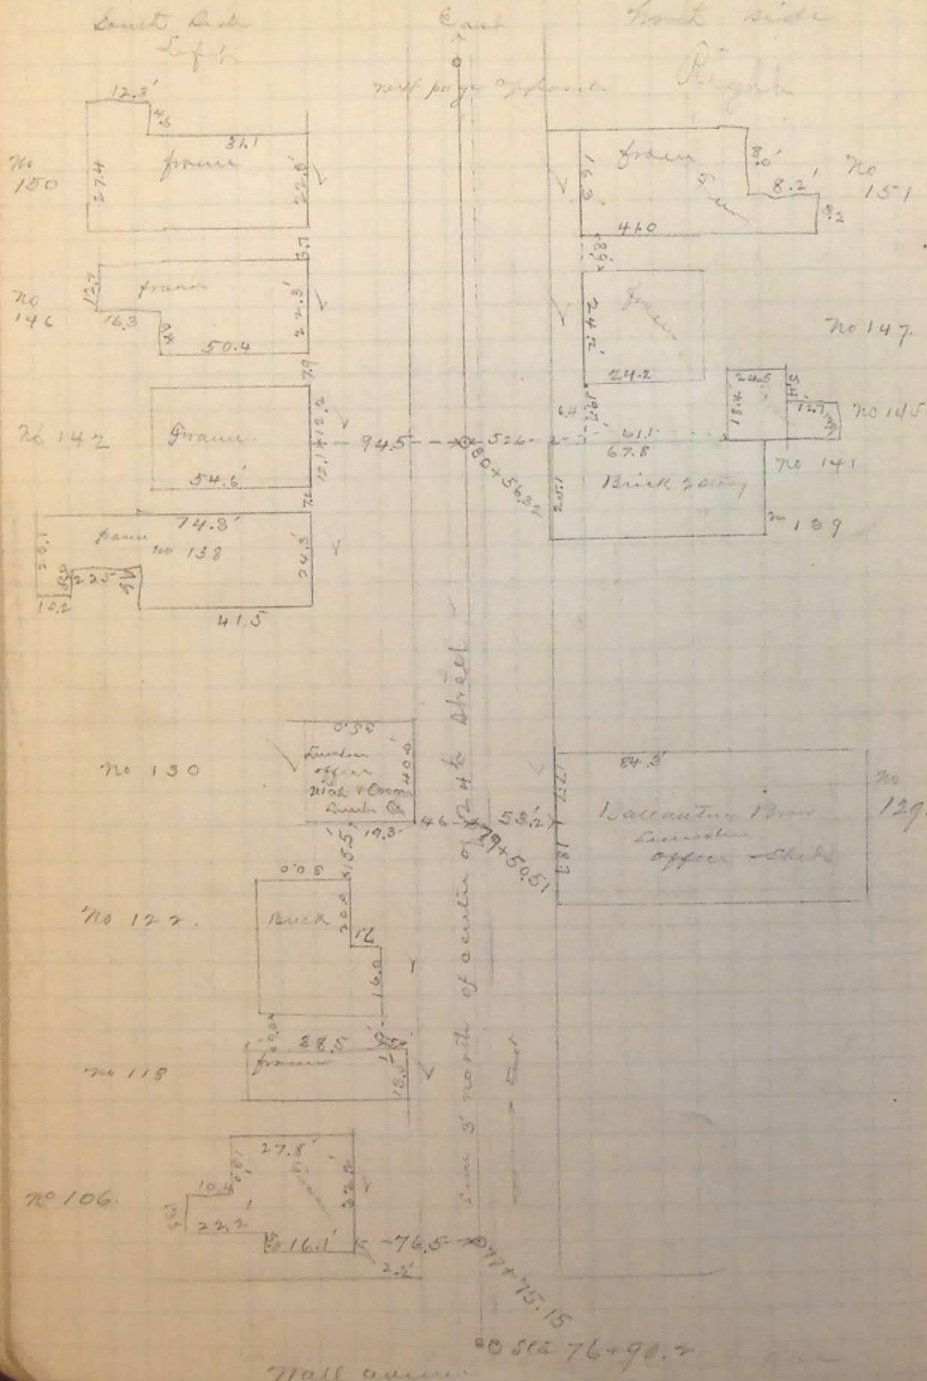

Platted
May 21st 1891
W.H. S.
and Eng.

Lincoln ave. 00 847557

