Location of building fronts on 24th St from Lincoln to Grant Avenue

May 19th 1891
W. M. B
and Engr

Grant Avenue.
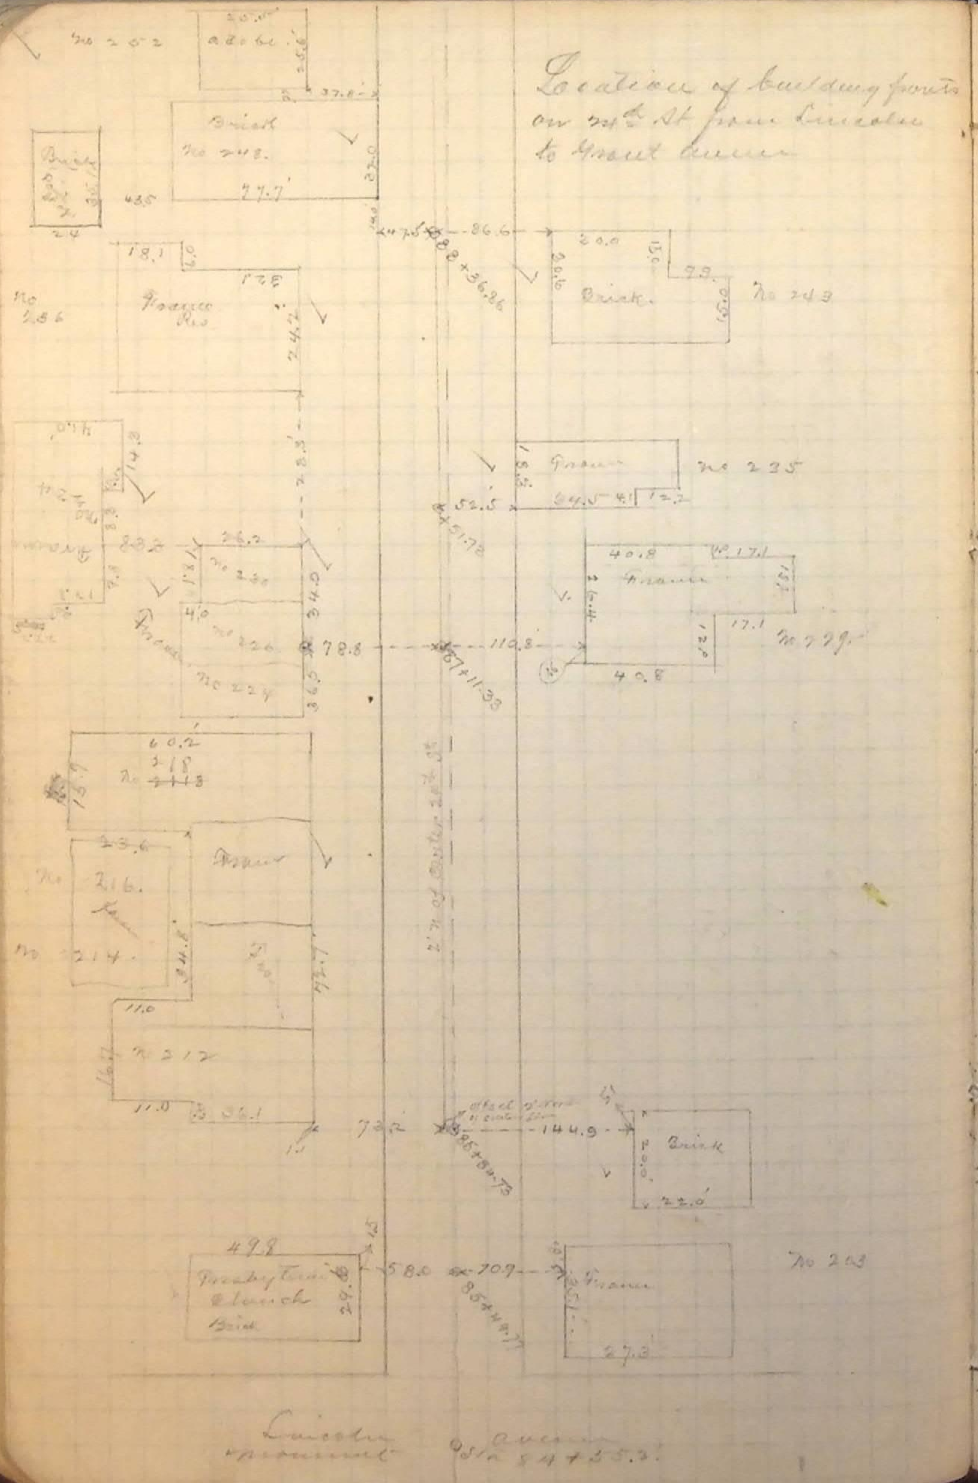
Plotted May 20th 1891
W. M. B.