Location of Building fronts on 23rd Street from Lincoln to 4th Street avenue

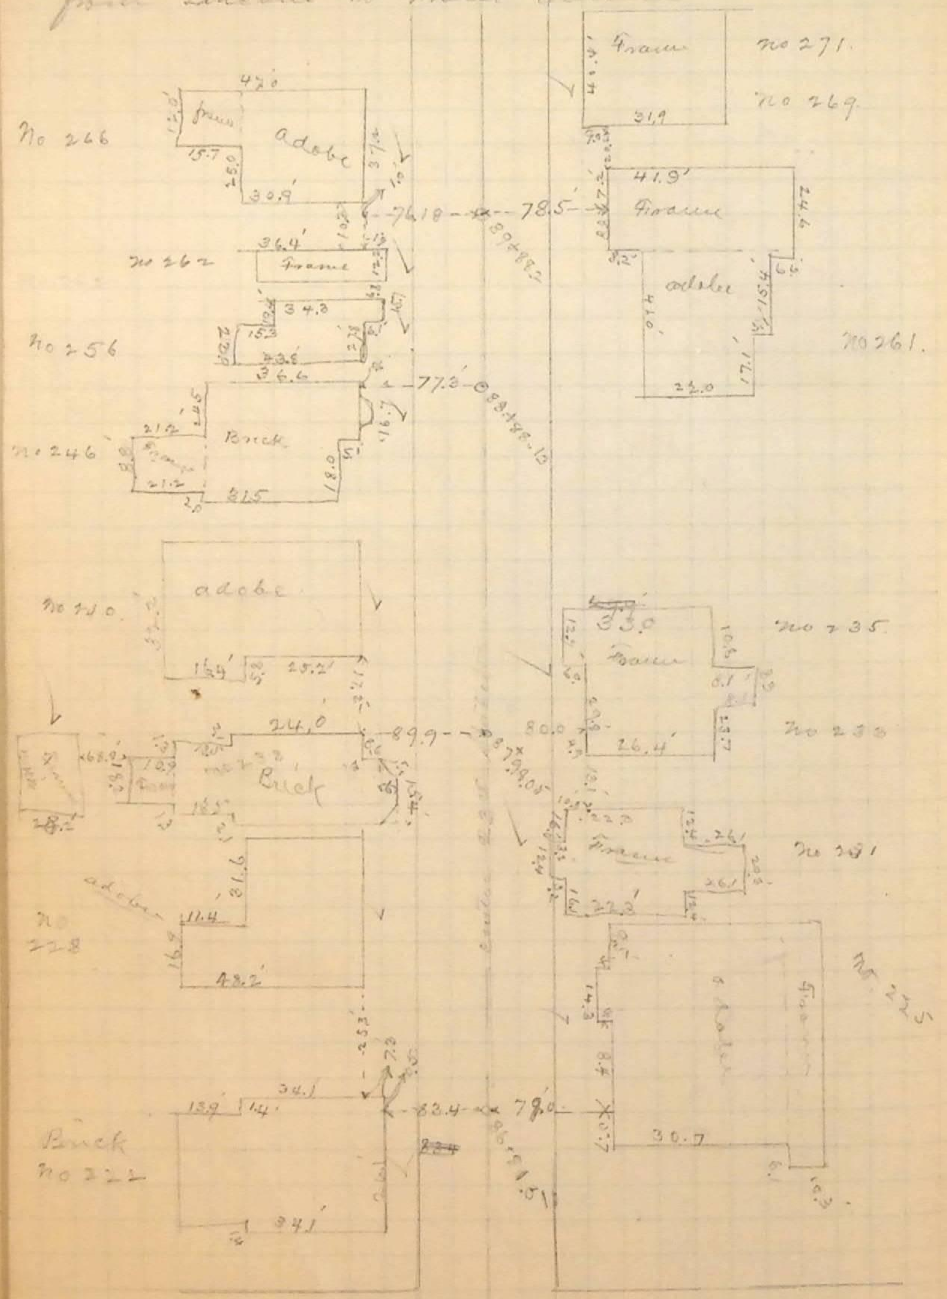


Street

Station 92 + 21.2 Elevation

Taken June 6th 1919. 25 m roots ph on Eye

Platted June 13th 1919 T.M.C.

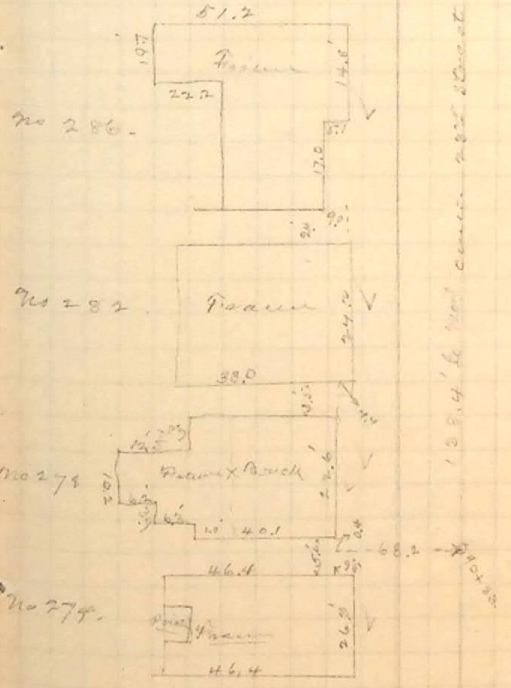


From 4th street page

Lincoln Avenue