


Location building fronts on 4th Street
 from Grant Avenue to Washington Avenue
 June 6th 1891
 Plotted June 15th 1891.

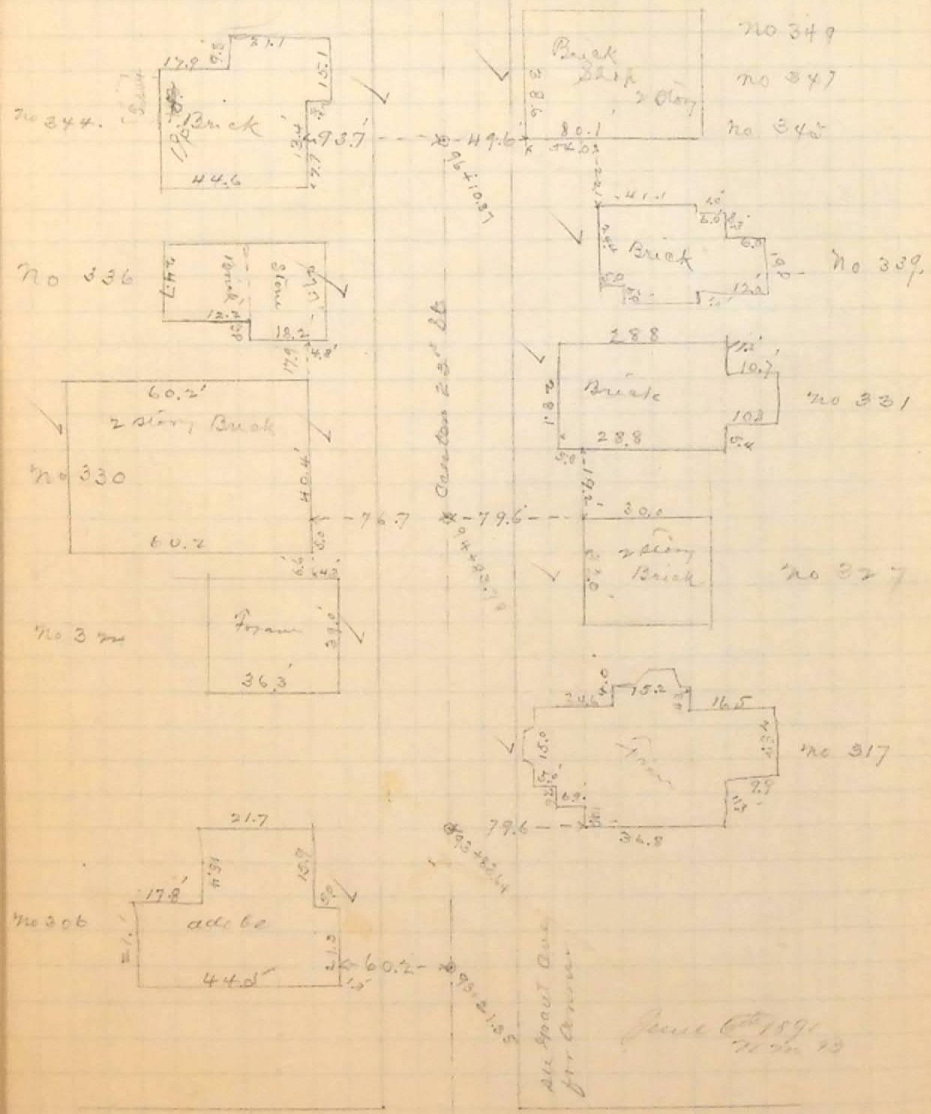

Grant Avenue
 June 15th 1891
 95 x 1.2

66
 Monument Washington Ave
 25 100.00

