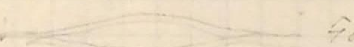


Washington Ave continued

Washington Ave and 19th Street from
Center of Avenue to Center of Track
of City. R. May met 4.28'

of a switch between 200 + 25' Shute 200 South
of 22nd St.  400

Now Ave + 17th St from Center Track Ave
to Center City Street R. May track is
3.22'

Washington Ave Center on Co. Monument
to N. 22' North of center of 14th Street
from main track to center of RR
track ~~3.09'~~ 3.09'

