


Location of building front on Washington Ave between 22723 Street

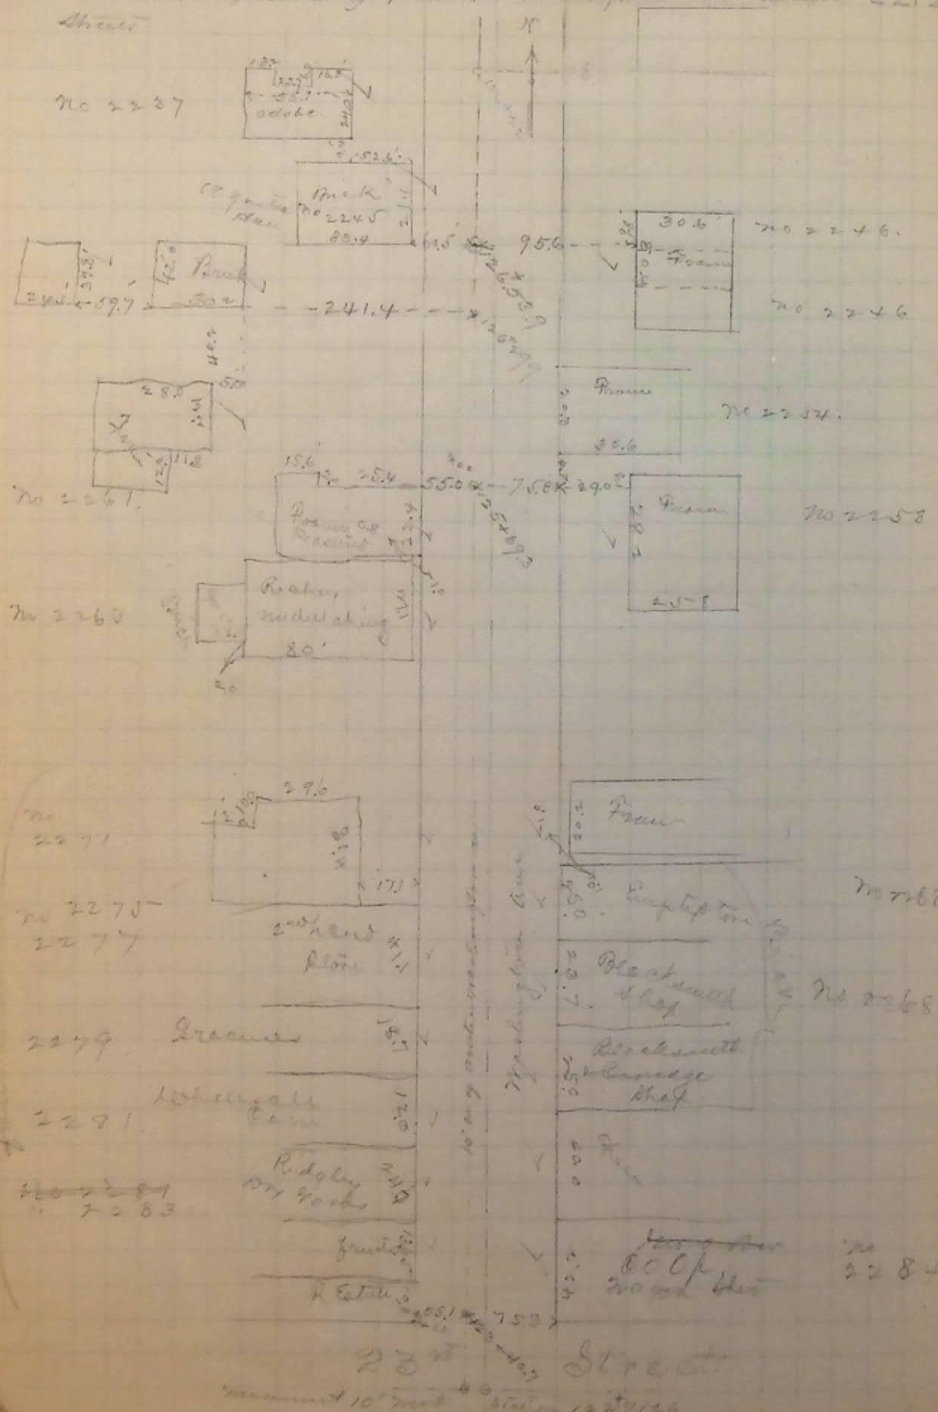

June 5<sup>th</sup> 1891  
 17th Post Office  
 and City

Platted  
 June 11<sup>th</sup> 1891

