

Aug. 19. 1891. P.M.

Continuation work
on page 33.

Now that the monument No. 99
has been found, I want to check
the measure of pp. 29 + 30 + c. with
that of Hollidge (T. F. 40 + 41. 2d J. A. P. 64)
and also to reduce the alignment
of pp. 30 + 29 with that previously done
so as to get the exact location of
Mt. 99.

In order to do so I make
the following observations (See diagram
in which the letters A, B, C, D, E ^{by same letters}
represent the same points as shown
p. 33.

Sitting on C' = Mt. trail + 24 ft
I read angles bet points M, + D,
as follows:


00°	15.50
	15.25
	15.00
	14.75
	15.00
	15.50
	15.00
	15.25
	15.12
	15.13

mean = 15.15 ✓ = 15' 09"

Sitting then upon D with F.S. at C'
(Mt. 24 + trail) I read angle to M, the
monument 99:

A. Verner	Quadrant	Quadrant	B. Verner
55°	47'	47'	46'
Telescope erect	47 1/2	46 3/4	46 3/4
	47'	46 3/4	46 3/4
Telescope inverted	46 3/4	47'	46 3/4
Mean of A. Verner	= 46.69		
" B. "	= 46.57		
" of Both Verner	= 55° 46.6 ✓		


Mt trail + 24 ft = C' - C

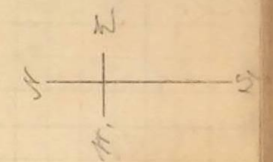

By Solving Triangle
C'MD, gives
C'M = 2824.43'

DC = DC' = 2832.87 feet.
from p. 29.

Note: This Dist. With Standardized
Tape & Std Pull. Corrected
for Terr. = 2824.8 =
Accepted & Estab. Dist.
WJF

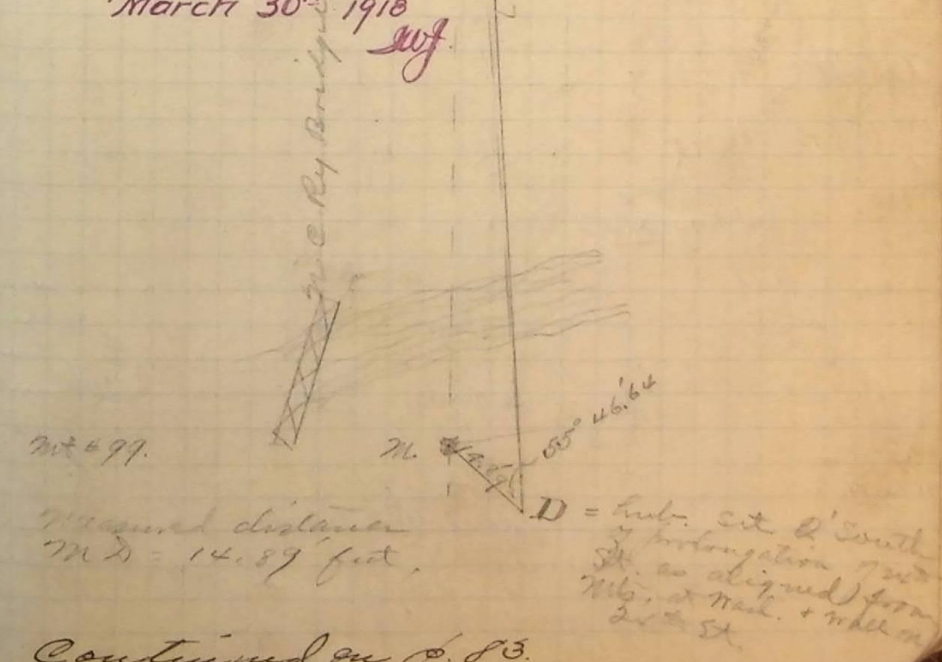

Mt 99.
Measured distance
M D = 14.89 feet.

D = hurb. etc. D South
of prolongation from
Mt. 99 as aligned from

