


26th Street - Wall Avenue East -
Location of buildings fronting

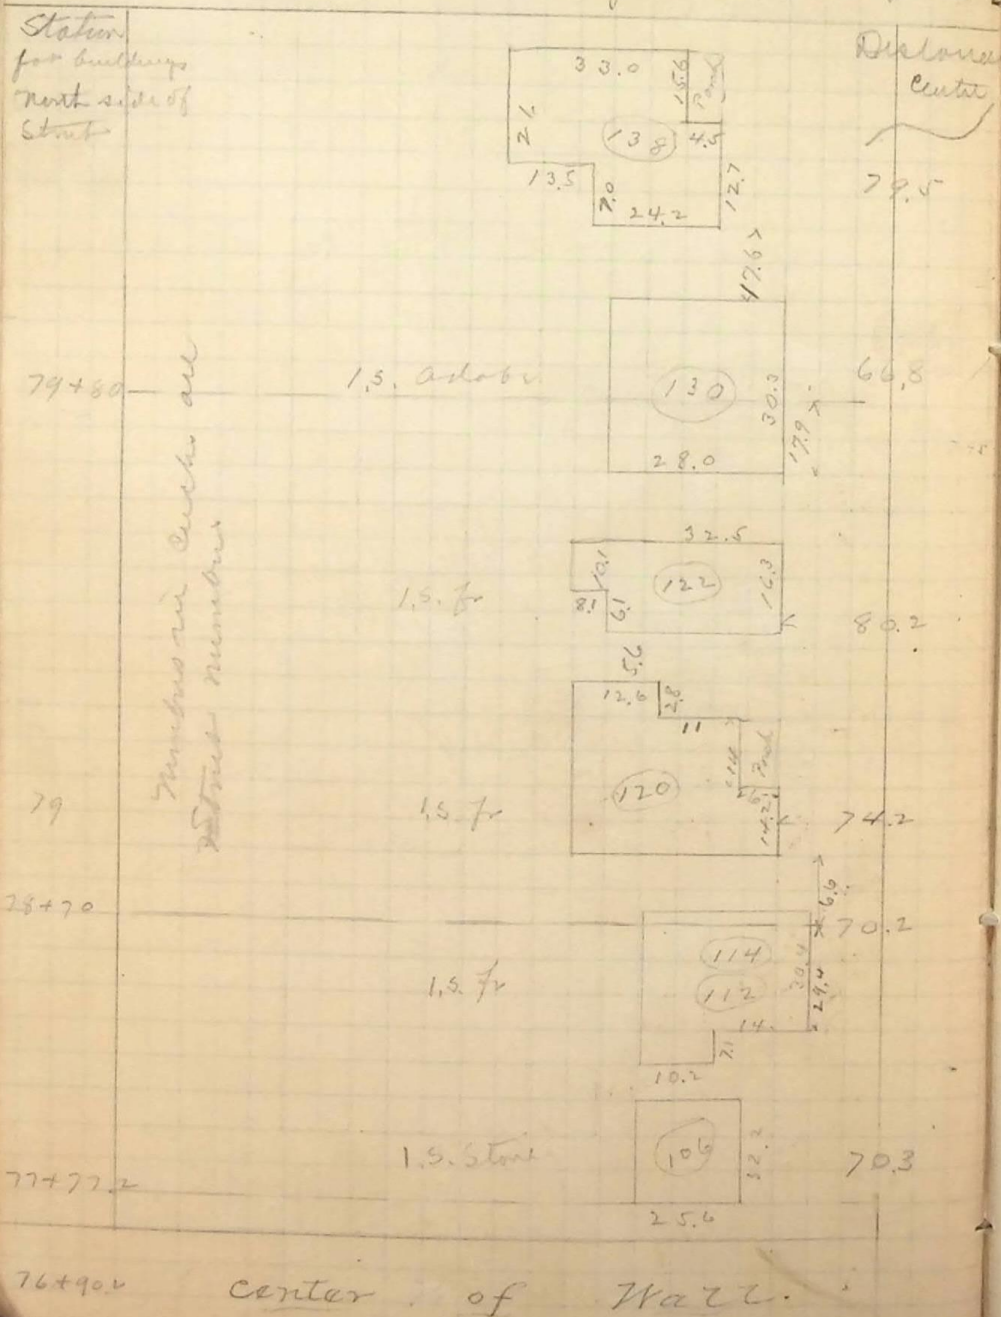

same -

Jan 5th 91

