


26th Street -- Continued

Location of House on
Sewer line between Lincoln &
Mill

Lincoln

Sta for buildings
on North side

Distance
from
Center
of Sta.

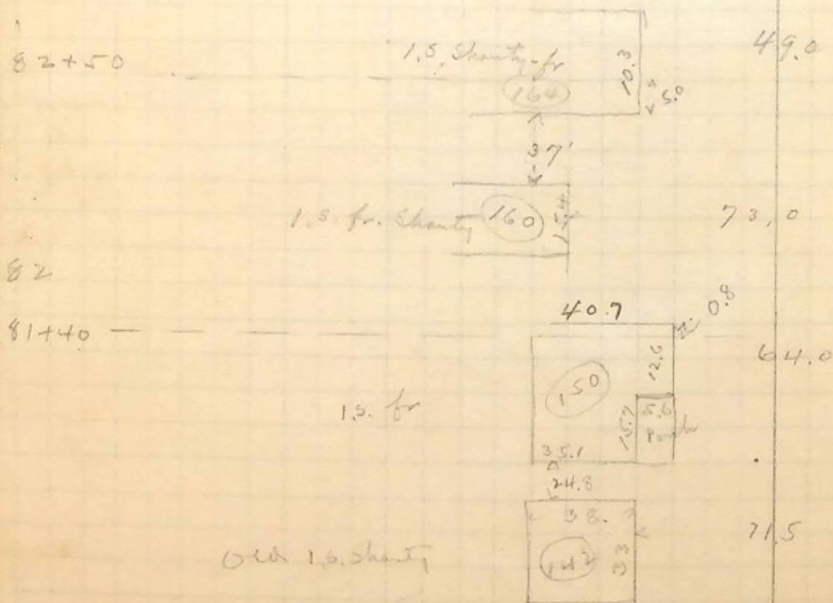

Avenue

Station for building
on South side of
Street

