
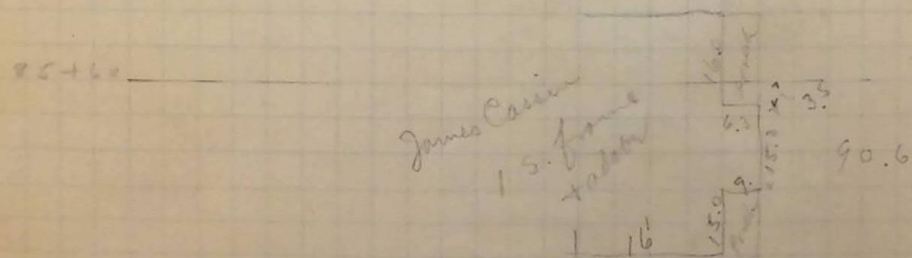
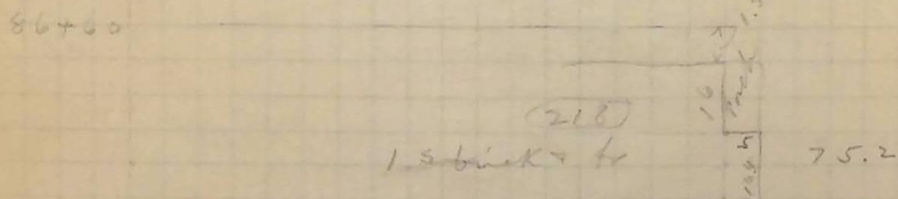
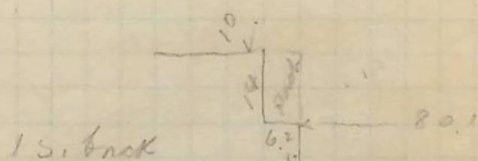
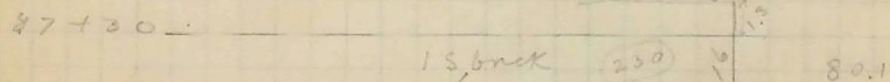








26th Street (continued)

East
↑

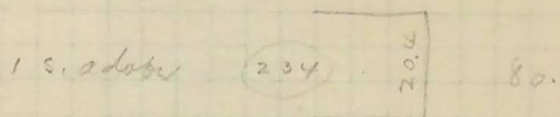

184+55.7 Center Lincoln

TWENTY-SIXTH STREET

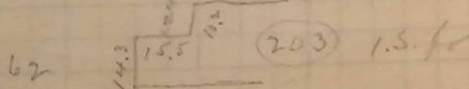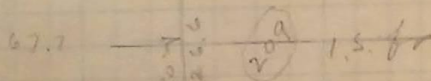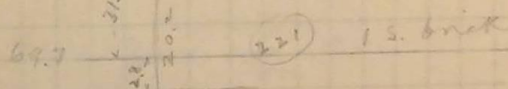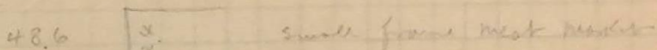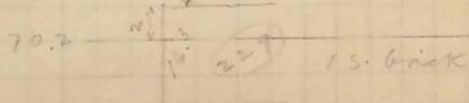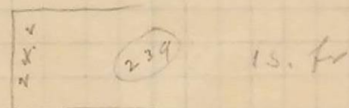

Acorn