


26<sup>th</sup> Street (Continued)  
Grant

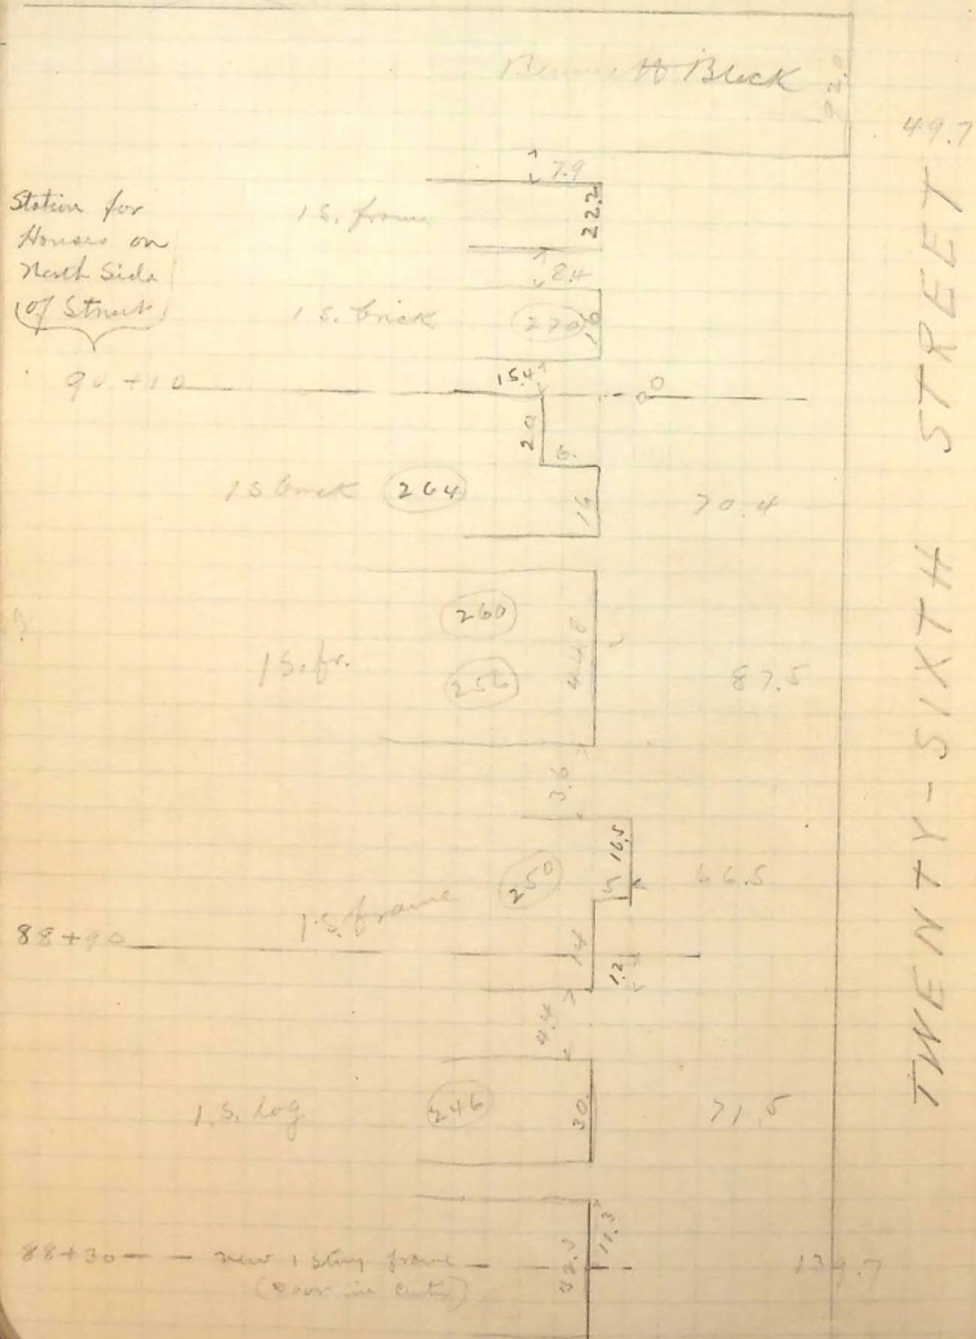

Avenue -

Continued on page 84

