


Survey to locate Mound fort School
House - Oct 8th 91

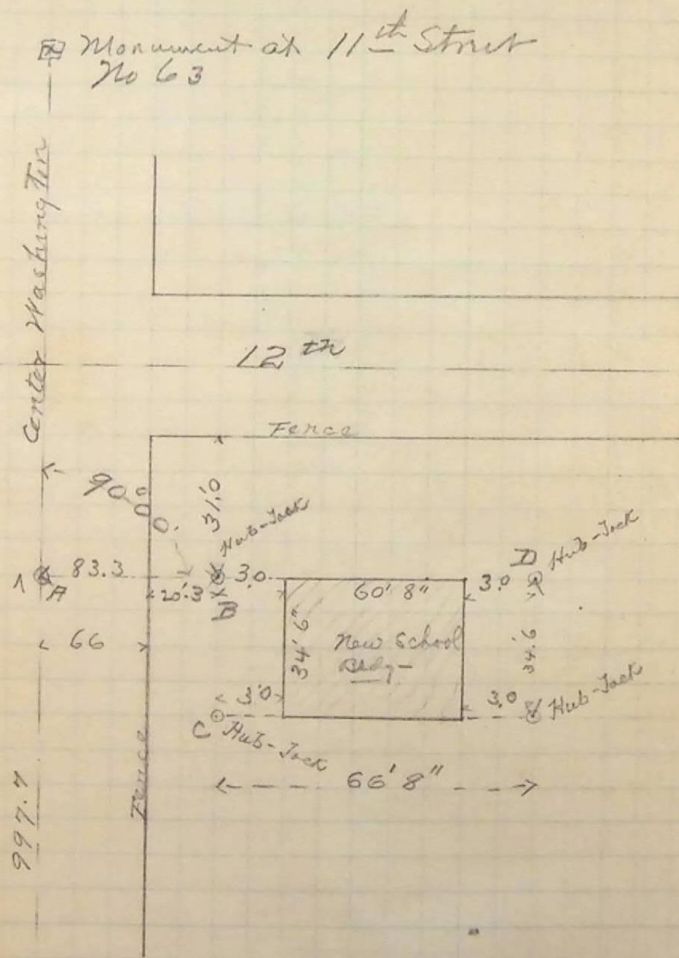

Co. Monument No - 4

Transit at No 63 - Sight at

No 4 - I set point "A" - Thence 90° 00' left

and set points B - C - D & E as shown
Also set stakes about 2' high - on same level
at B, C, D & E - for Datum plane