


26th Street - Location of
 buildings between Grant Ave
 and Washington Avenue.

Washington Avenue - 00

(Station 84)

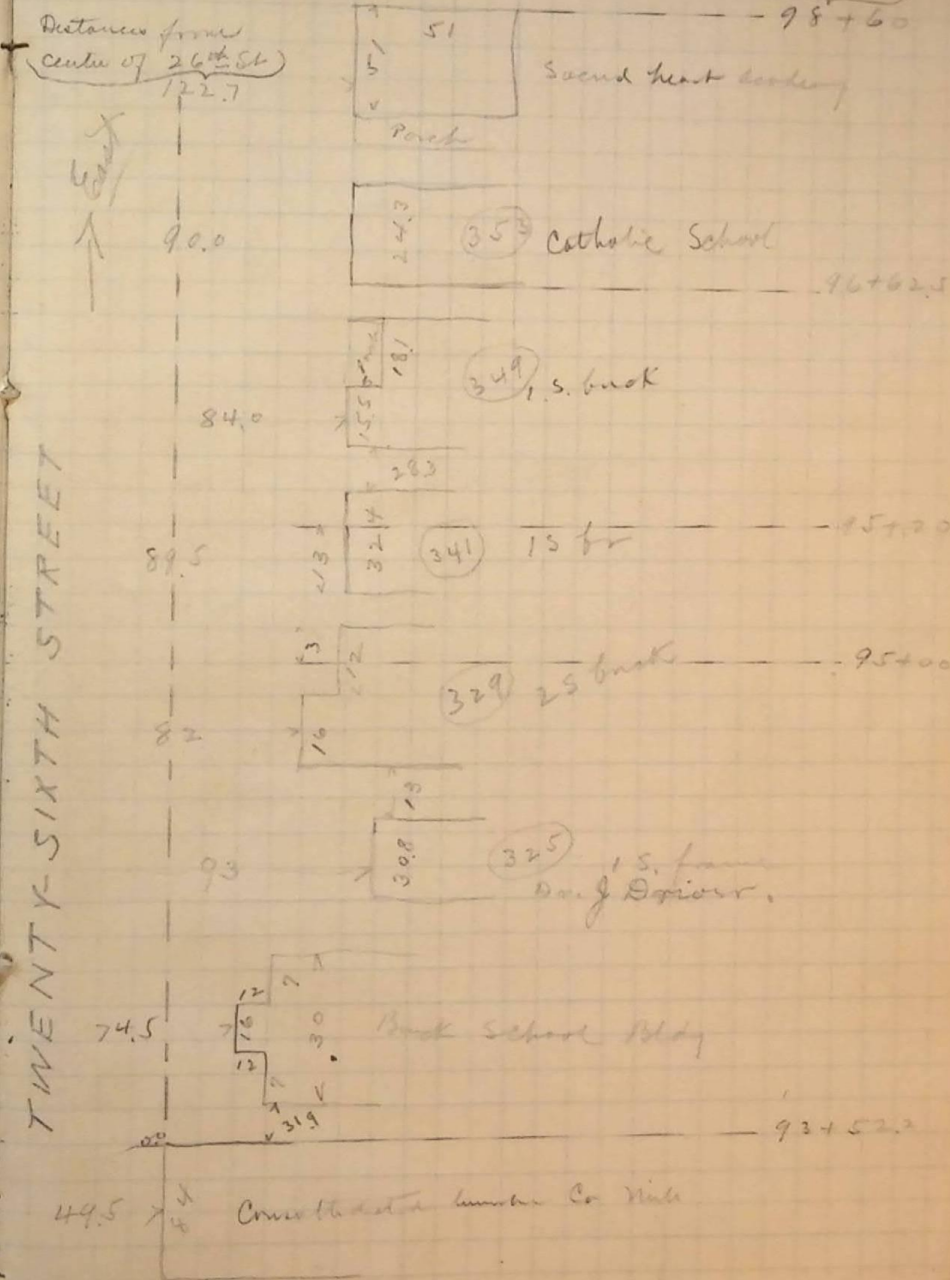

92+21.2 - Center of Grant Ave -