


Lincoln Ave - Location of buildings between 26th + 25th

Jan 6th 92

85

Station of building on West side of Street

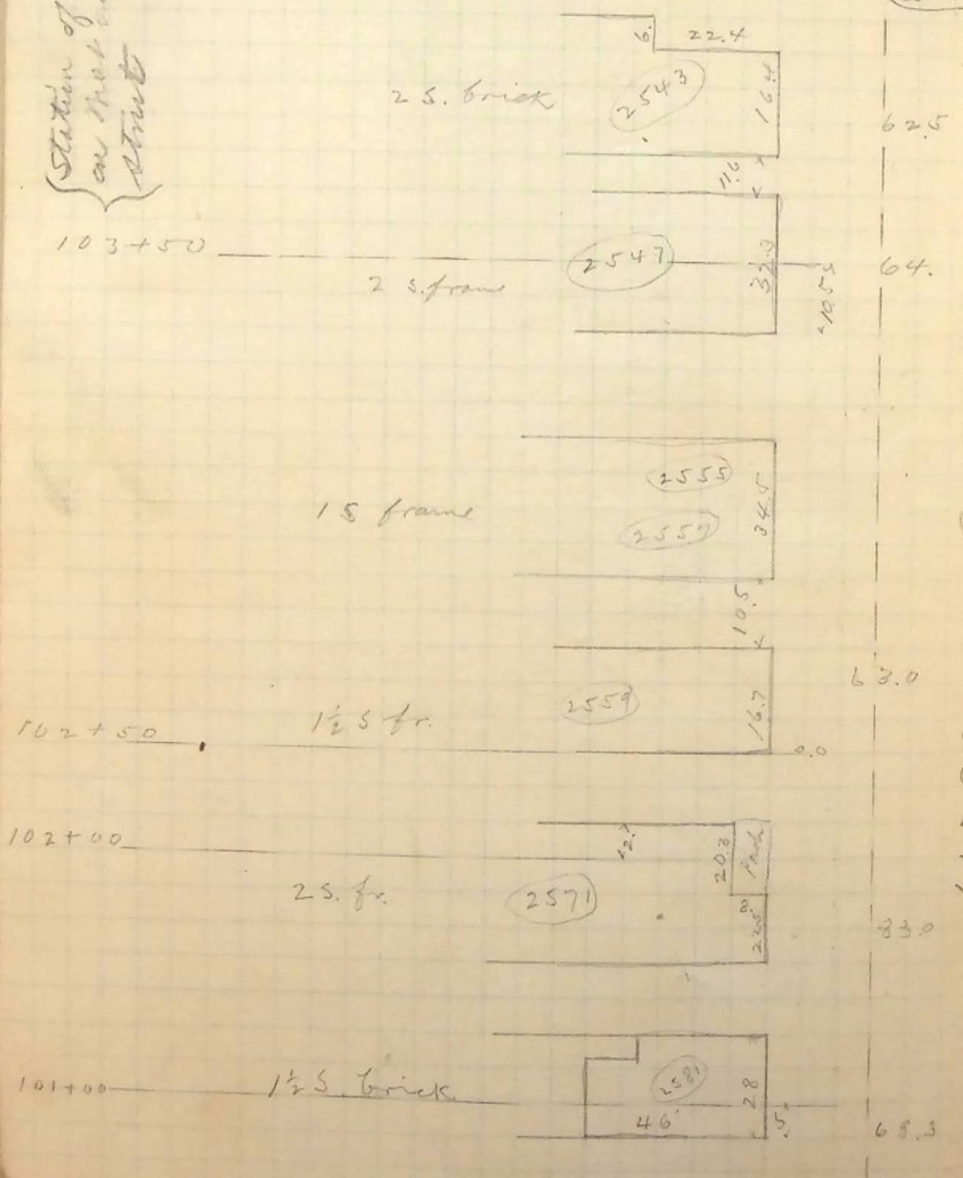


Distances from center of street

LINCOLN AVENUE

West

Station for building on East side of Street

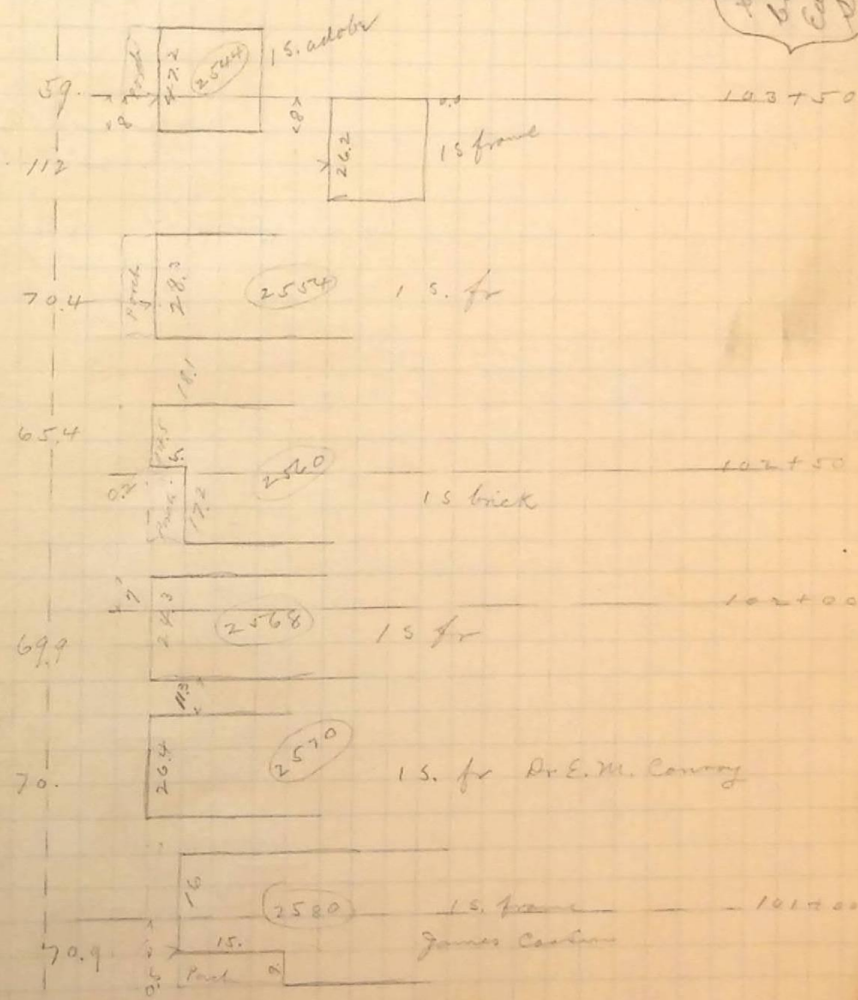

Center of 26th Street

100