


Lincoln Ave - between 26<sup>th</sup> and 25<sup>th</sup>

Location of buildings on same  
Jan 6<sup>th</sup> 92

25<sup>th</sup> Street


stations for  
buildings on  
West side of  
Street

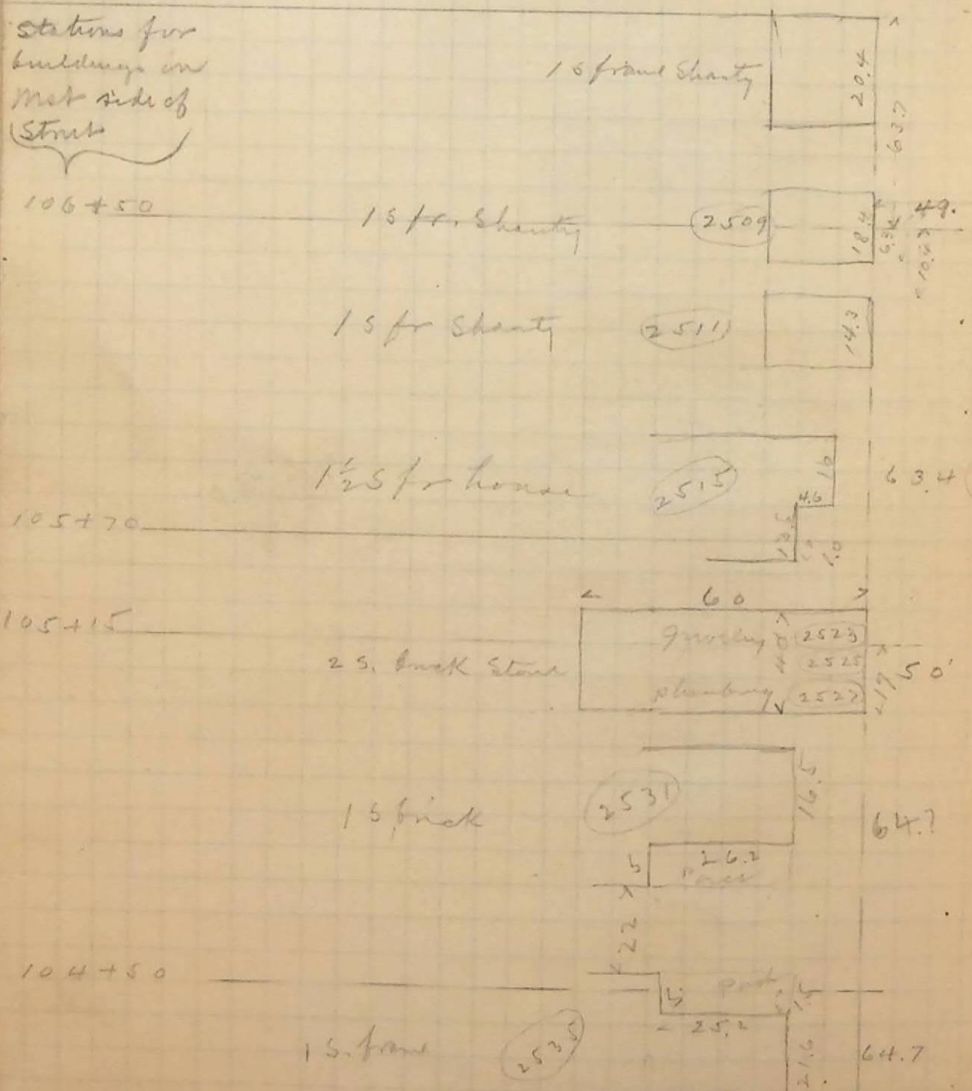

Street

25<sup>th</sup> Street

stations for  
buildings on  
East side of  
Street

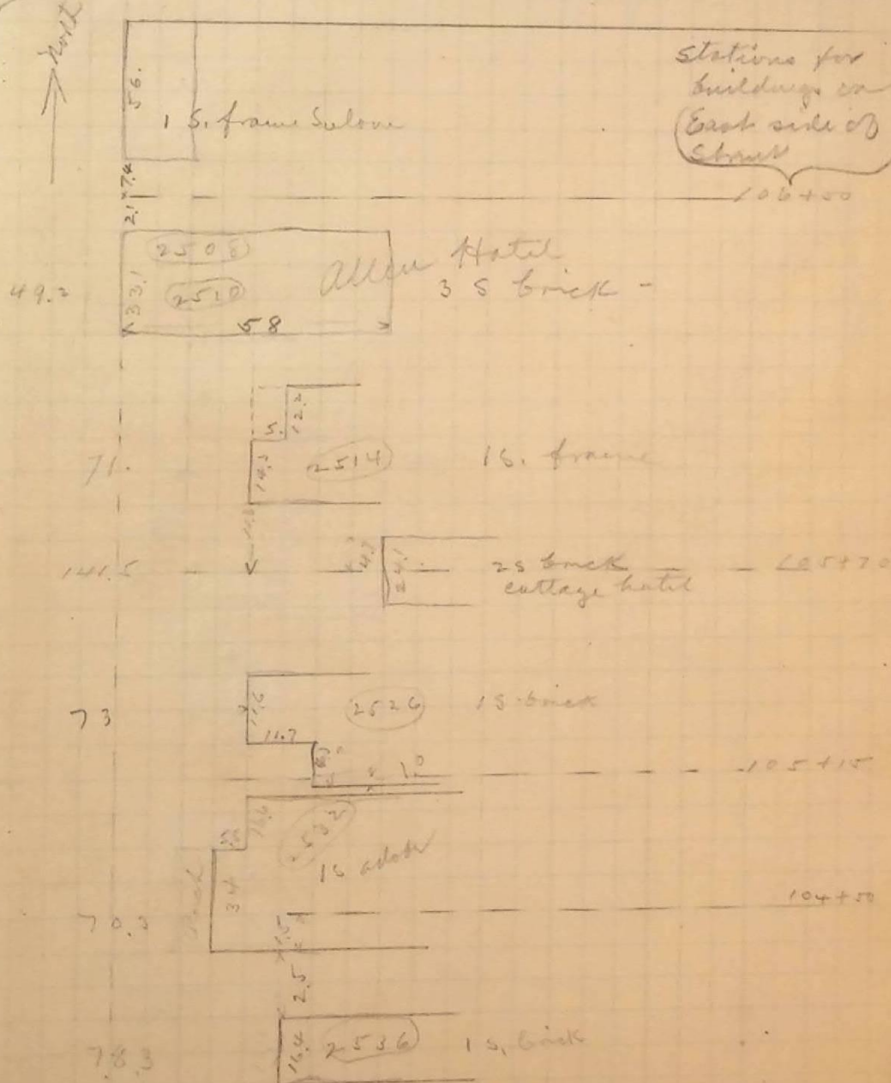

Distance to Center  
Street

