

25th Street - from Washington -  
 Location of buildings along

to Adams -  
 same -

Jan 7<sup>th</sup> 92

107+76.5 = Center Adams


Across

Station  
 for  
 Buildings  
 North side  
 of Street

Distances  
 Center  
 Street

East  
 ↑

Station for  
 Buildings  
 on S. Side  
 of Street

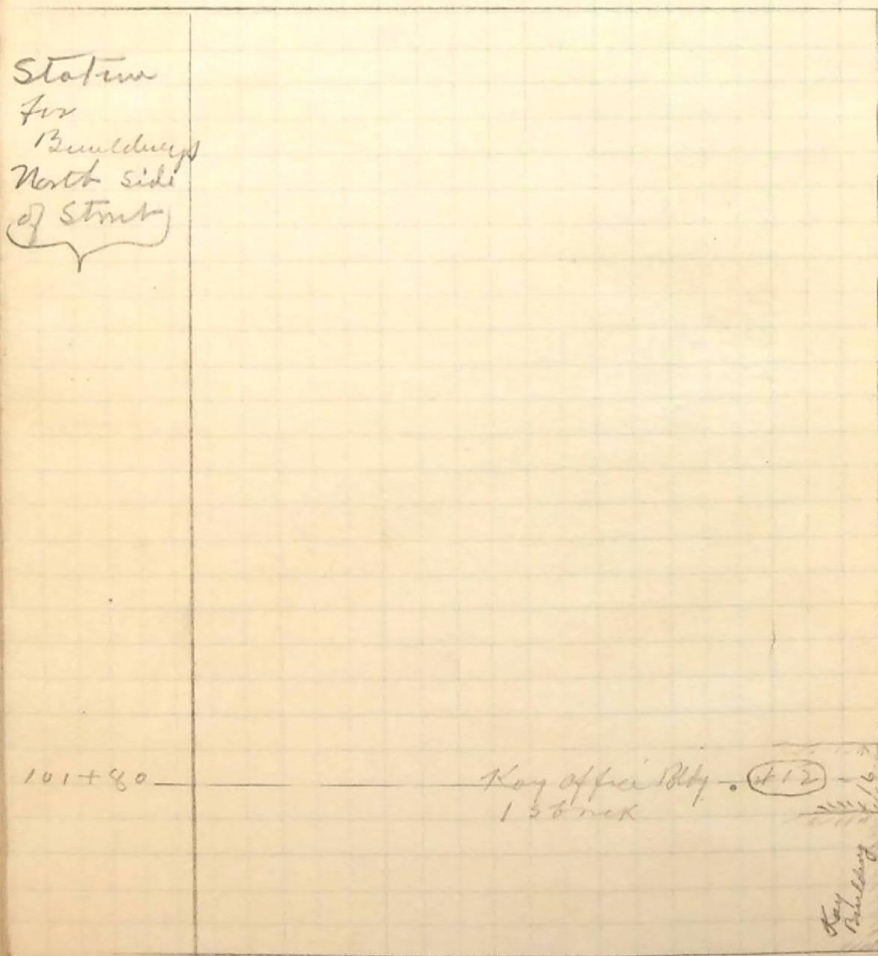

100 = Center Washington Ave

