
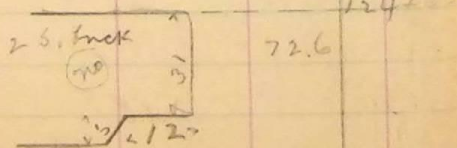
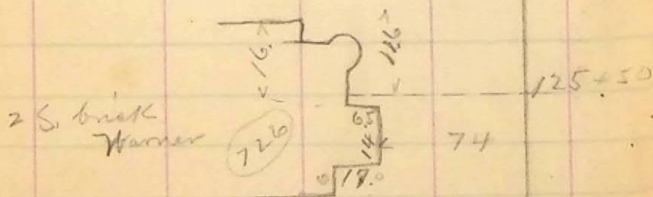
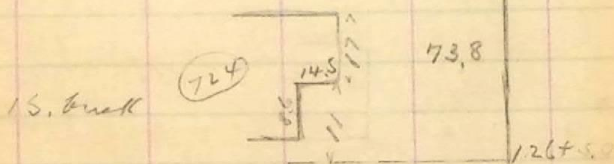


25th Street - from Madison
 Location of buildings on same
 Jan 7th 92

Monroe Avenue

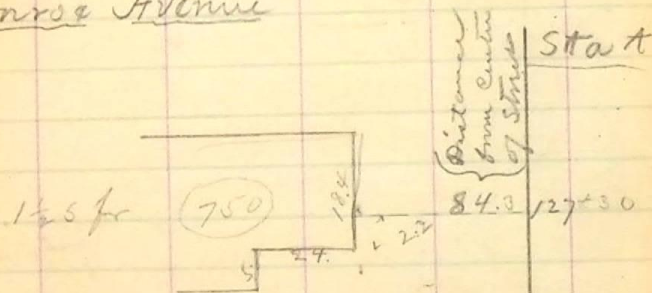

Madison ave