
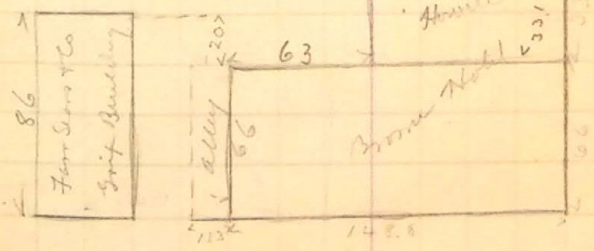
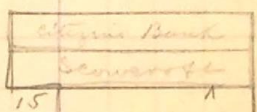
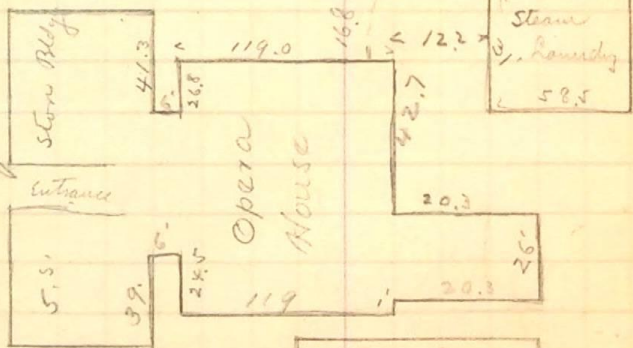


7th

Jan 20/92

Washington Ave

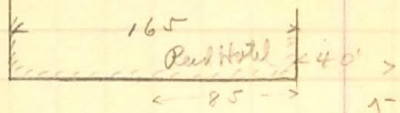

Howell
Brown Hotel