


path


Jan 20/92

Washington Ave

24th Str

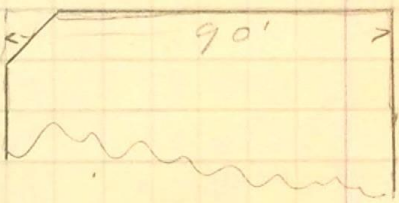

^

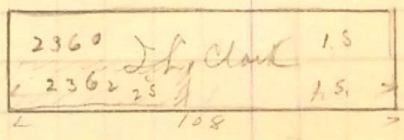

Washington Ave

