

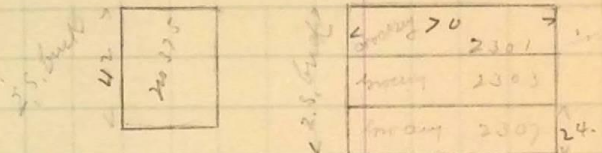


23^d Street


June 20/92

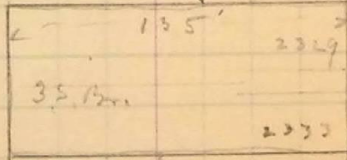


Meat Market 25
 Bakery
 2311
 2313

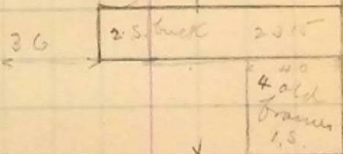

ashby, Sher St 15 ft. 70

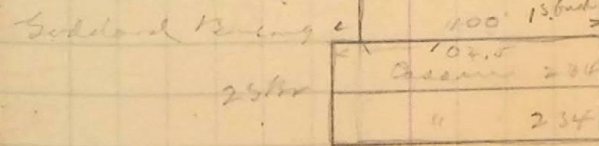

Nations
 Drugs + Music 70
 15.
 100

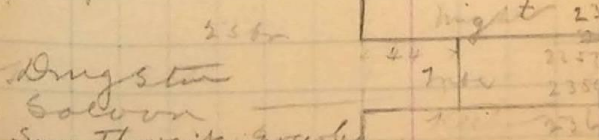

Drug store
 Saloon
 Sunthwait - groceries
 Kuhn clothing 100
 35 ft. 2365

11th Street