Jan 20/92

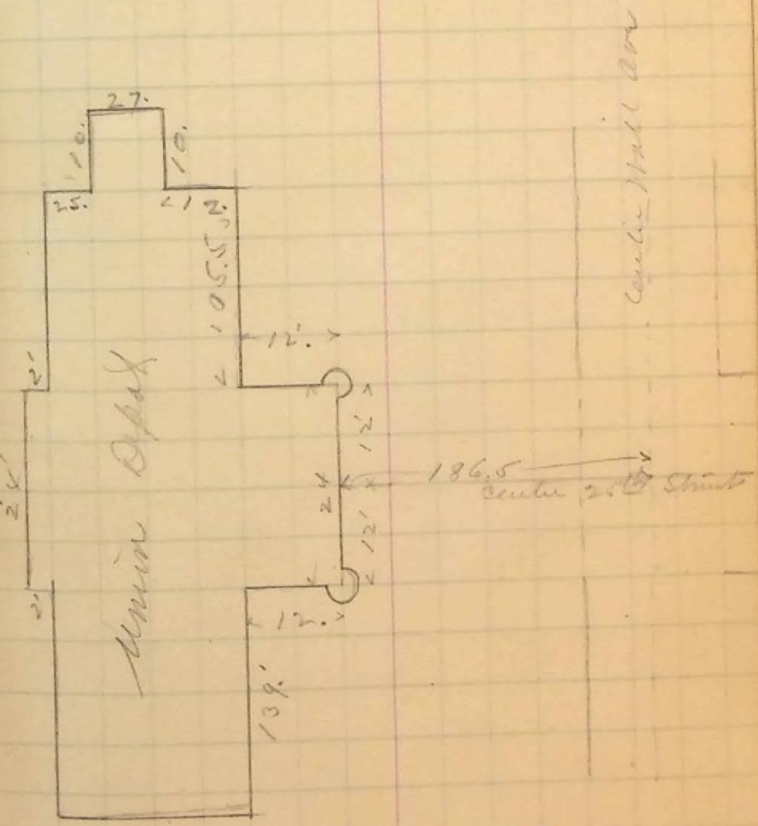
27.
10.
10.
25.
12.
105.5
12'.
2'
24'
2'
12'
24
12'
12.
139'
Union Depot
186.5
Centre 25th Street
Centre Hall Ave