Washington Ave

North
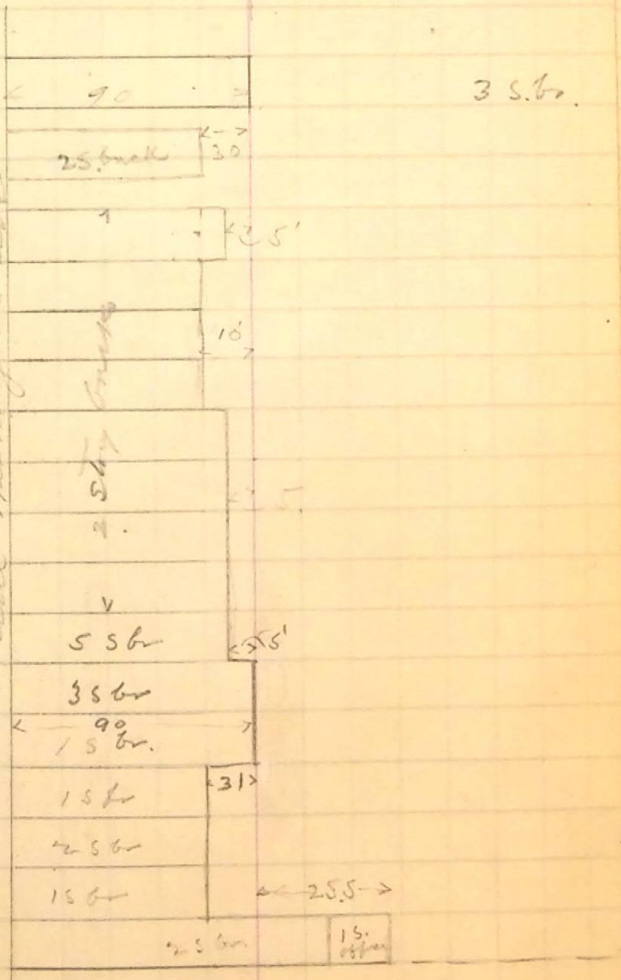
Jan 21/12