


Jan 21/92

West
↑

North line 25th Street

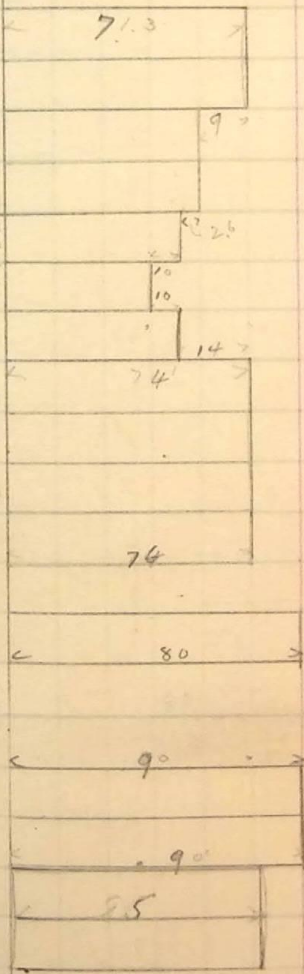

↑

1 story breaks

2 story

✓

2 S. breaks

2 story breaks ✓