

24th Street - Adams East  
 Location of buildings


Jan 29th 192

Station N. Side

111435


Distance from Center

Kuhel  
 2 S. Br.

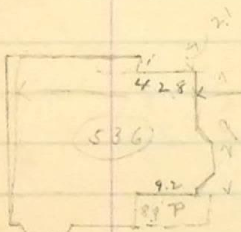


90.

110460

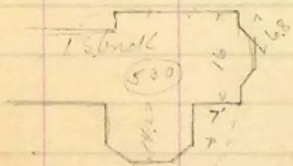


74.2

Farly on  
 15.00

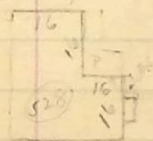


75.5

110400

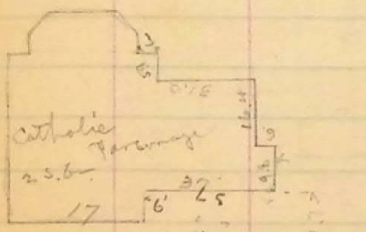

79

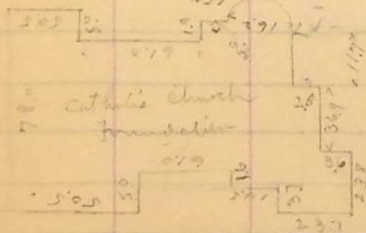

61.4

109400

Adams

107726.5