


P = Pouch

Stations


(S. Side)

84.

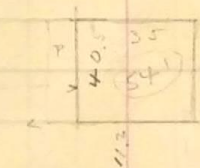

738


110-766

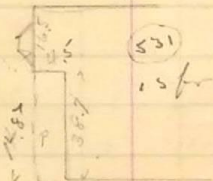

17th angle

109400

71

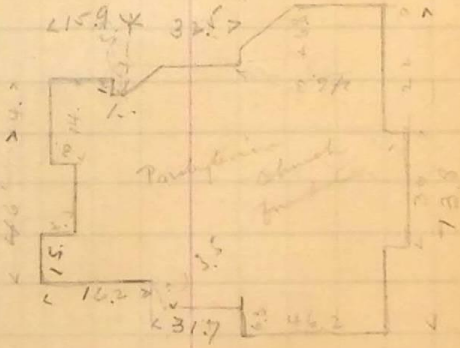

Avenue