

[concluded] Jan 29<sup>th</sup> 92 37


SOUTH SIDE

ATONING


Station  
S. side  
114+75

Distances  
from center


70.3

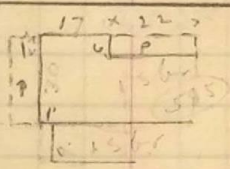


71.0

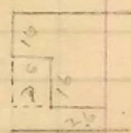


71.0

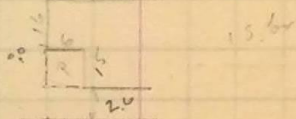

75.7

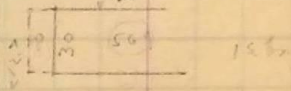


70.7

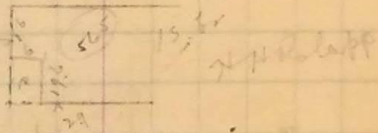

112+70

75.7

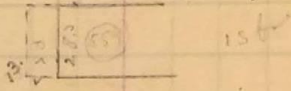

112+00

75.5

