


24th Street - from Jefferson
 Location of Buildings

Distance from Center Station

LANE

fence


2.15 119+30

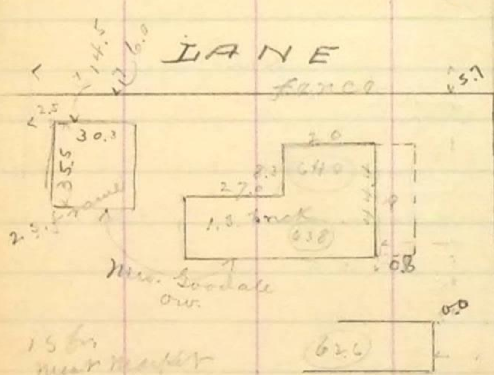


72.6 118+75

118+02

53.7

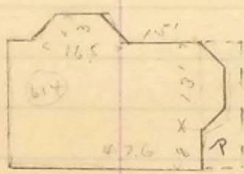


25 ft
 Mrs. M. M. Witt
 ov.

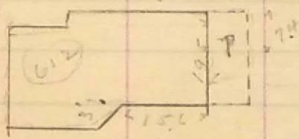

March alley
 28 ft
 ov.

74.5

116+75

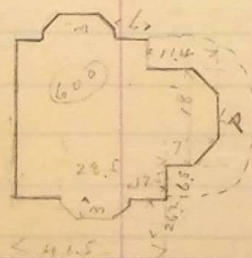

25 brick
 Stearns
 ov.

71.0

115+75

Jefferson