24th Street - from Jefferson to
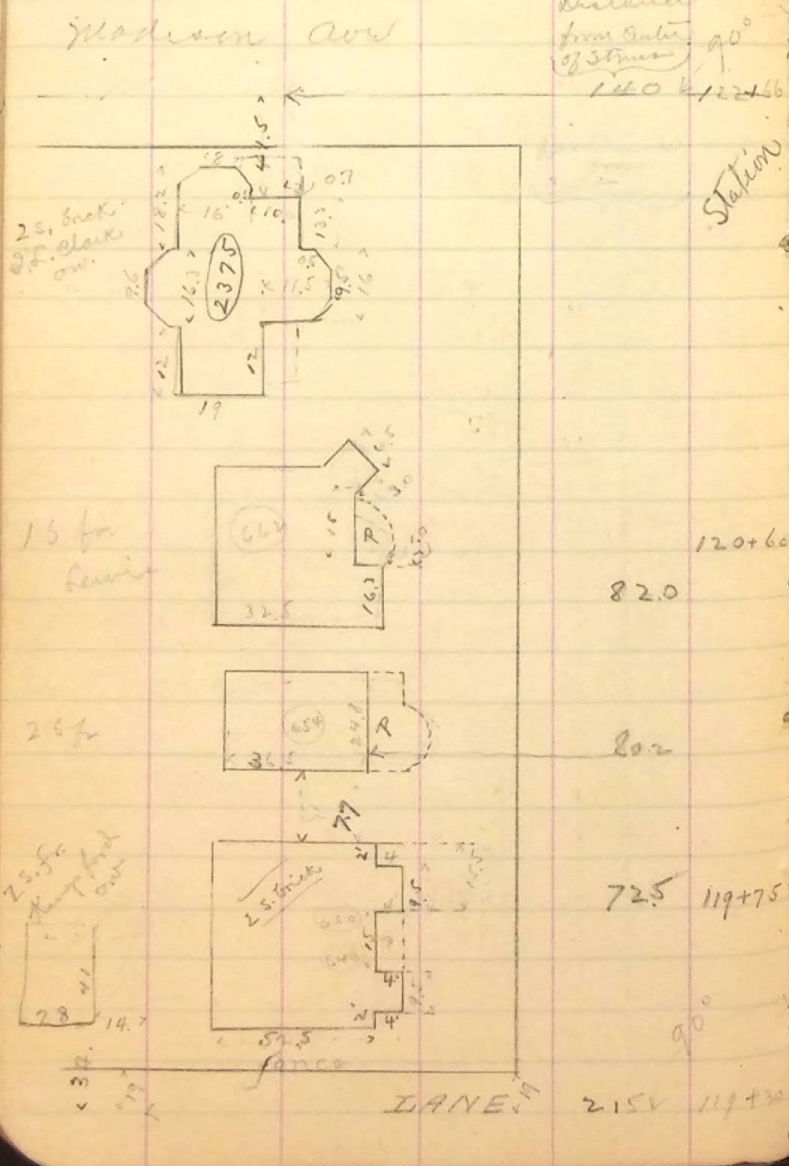
Location of buildings