24th Street – from Madison Ave. to Monroe Ave – Location of Buildings –

1 S. brick

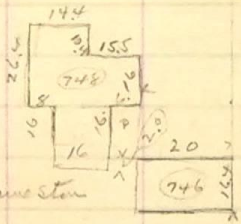

84.9

1 S. frame stor

49.0

Folger (owner)

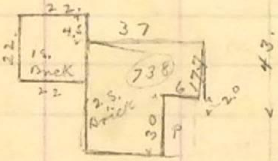

97.6

126+50

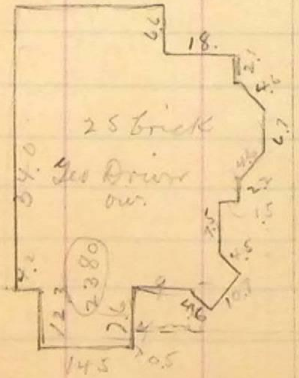

117.5

124+9

Madison