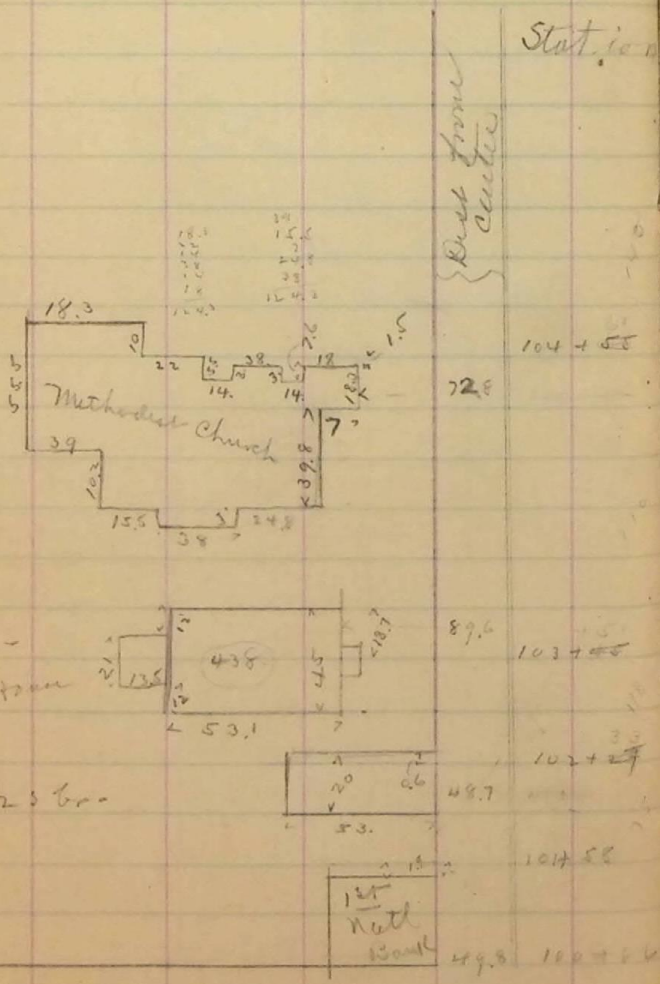24th St. Washington
Location of buildings