

March 1<sup>st</sup> 92 -

Distances  
from Center

151  
103 + 48

177.3

33  
102 + 47

149.5




101 + 58

159.5

100 + 66

166

100

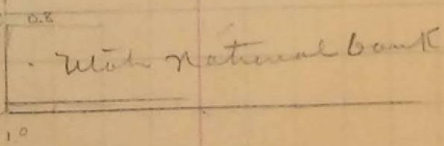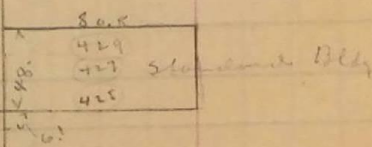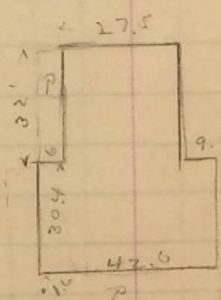

Adams